

July 17, 1958 - 3980

Registration No. GR ~~3980~~

Certificate No. GR - 3591

RECEIVE

JUL 17 1958

Registration Statement

OF CLAIMANT OF RIGHT TO APPROPRIATE GROUND WATER

4

TO THE STATE ENGINEER OF OREGON:

I, Jack C. Barr
of Rte #2 Box 770, Troutdale County of Multnomah
(Mailing address)

State of Oregon, do hereby make application for a certificate of registration as evidence of a right to appropriate ground water.

1. Source from which water is withdrawn is Pump well
(Flowing well, pump well, infiltration trench, or tunnel)

2. Location is: 3 1/2 miles N.E. of Gresham, Oregon
(Approximate distance and direction from nearest city or town)

and is more particularly described as follows:

(a) S. 22° 45' E from West 1/4 cor Section 35
(Give distance and bearing to corner of section or other legal subdivision)

being within NW 1/4 SW 1/4 of Sec. 35, Twp. 1 N, Rge. 3 E
(Smallest legal subdivision) (N. or S.) (E. or W.)

or (b) within limits of recorded platted property, town or city:

in Lot _____, Block _____ of _____
(Name of plat or addition)

County of _____
(If within city or town, give name)

3. Construction Work was begun on July 1949; was completed on Aug 1949
(Date) (Date)

and the ground water claimed was first used for the purposes set out below on Aug 1949
(Date)

since which time the water has been used intermittently
(Continuously or intermittently)

from April to October
(Date) (Date)

4. Quantity of water claimed and used is 15 gallons per minute; 50 acre feet per year.

5. Purpose or Purposes for which water is used irrigation

(Domestic, irrigation, municipal, manufacturing, industrial, etc.)

6. Description of Well: Depth 112 feet. Type Drilled
(Dug or drilled)

diameter 6" inches. Elevation of ground at well site 340 feet, mean sea level.
(As near as known)

Depth to water table 73 feet.

7. Capacity of Well: _____ g.p.m. with _____ feet drawdown.

_____ g.p.m. with _____ feet drawdown.

Date of test No test

If Flowing Well: Measured discharge _____ g.p.m. on _____
(Date)

Shut-in pressure at ground surface _____ lbs. per sq. in. on _____
(Date)

Water is controlled by _____
(Cap, valve, etc.)

8. Casing: (Give diameter, commercial specifications and depth below ground surface of each casing size.)

6 inch diameter *Steel* from 0 to 12 feet
..... inch diameter from to feet
..... inch diameter from to feet
..... inch diameter from to feet

Describe and show depth of shoe, plug, adapter, liner or other details:
.....

9. Perforated Casings or Screens:

None from to
(Number per foot and size of perforations, or describe screen)
..... from to
..... from to
..... from to

10. Log of Well: (Describe each stratum or formation clearly, indicate if water bearing, and give thickness and depth as indicated.)

MATERIAL	Thickness (Feet)	Depth to Bottom (Feet)

If log of well is not available, give name and address of driller. O.B. Olsen

Gresham, Ore

11. Infiltration Trench: Covered or open
 Dimensions: Length ft. Minimum depth ft. Maximum depth ft.

Bottom width ft. Discharge g.p.m. Date of test

12. Tunnel: Type of lining

Dimensions:
(Length, course, and cross sectional size)

Position of water bearing stratum with reference to portal of tunnel

Log of tunnel: (Preceding table for log of well may be used, if desired. Give footage from portal and character of materials, as pertinent.)

13. Pumping Equipment:

(a) Pump Jacuzzi (Berkeley) Jet 3/4" Capacity 15 g.p.m.
(Make, type and size)


(b) Motor 1 HP electric
(Type and horsepower)

14. Location of area irrigated or to be irrigated, or place of use if for purposes other than irrigation.

Township North or South	Range E. or W. of Willamette Meridian	Section	Forty-acre Tract	Number Acres To Be Irrigated	Date of Reclamation
<u>1N</u>	<u>3E</u>	<u>35</u>	<u>SW 1/4 NW 1/4</u>	<u>1.5</u>	<u>Aug. 1949</u>
<u>1N</u>	<u>3E</u>	<u>35</u>	<u>NW 1/4 SW 1/4</u>	<u>18.0</u>	<u>Aug 1949</u>
				<u>19.5 Ac</u>	

15. If the ground water supply is supplemental to an existing water supply, identification of any application for a permit, permit, certificate or adjudicated right to appropriate water made or held by the registrant.

Township 1N Range 3E, W.M.
North

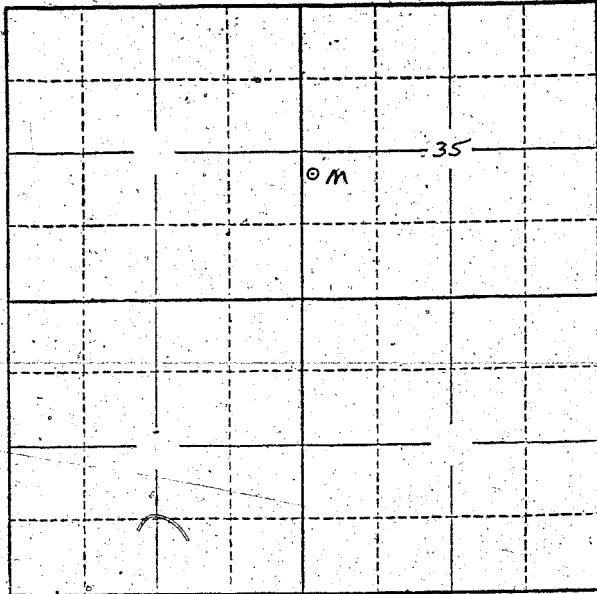

Locate well and acreage of irrigated land on plat.

Scale: 2" = 1 Mile

STATE OF OREGON

County of Marion } ss.

I, Jack C. Barr, being first duly sworn, do hereby certify that I have read the foregoing Registration Statement and that all of the items therein contained are true to the best of my knowledge and belief.

Jack C. Barr
(Signature of Registrant)

Subscribed and sworn to before me this 30 day of July, 1958

My commission expires _____

Lawrence E. Orr
(Notary Public)

(SEAL)

MY COMMISSION EXPIRES MAY 12, 1962

CERTIFICATE OF REGISTRATION

STATE OF OREGON }
County of Marion } ss.

This is to certify that the foregoing Registration Statement was received in the office of the State Engineer on the 4th day of August, 1958, at 1:00 o'clock P.M. and has been duly recorded in said office in Book No. 15 of Registration Statements on page GR-3594

Witness my hand this 15th day of September, 1959

Alvin A. Stanley
(State Engineer)

\$15.00

By _____
(Deputy)

GR 3594