

Registration Statement

OF CLAIMANT OF RIGHT TO APPROPRIATE GROUND WATER

(Under Chapter 708, Oregon Laws 1955.)

TO THE STATE ENGINEER OF OREGON:

I, William Vogt
of 5665 Caplinger Rd County of Wasco
State of Oregon, do hereby make application for a certificate of registration as evidence of a right to appropriate ground water.

1. Source from which water is withdrawn is Pump well
(Flowing well, pump well, infiltration trench, or tunnel)

2. Location is: Six miles east of Salem on Wasley Rd
(Approximate distance and direction from nearest city or town)

and is more particularly described as follows:

(a) 127' ch N 95' ch West from East 1/4 Corner Section 32
(Give distance and bearing to corner of section or other legal subdivision)
being within SE 1/4 of NE 1/4 of Sec. 32, Twp. 7S, Rge. 2W
(Smallest legal subdivision) (N. or S.) (E. or W.)

or (b) within limits of recorded platted property, town or city:
in Lot _____, Block _____ of _____
(Name of plat or addition)

County of _____
(If within city or town, give name)

3. Construction Work was begun on May 25, 1947 was completed on June 1, 1947
(Date) (Date)

and the ground water claimed was first used for the purposes set out below on _____
(Date)
since which time the water has been used Intermittently
(Continuously or Intermittently)
from 1947 to 1958
(Date) (Date)

4. Quantity of water claimed and used is 100 gallons per minute; 30 acre feet per year.

5. Purpose or Purposes for which water is used Irrigation and stock
watering stock
(Domestic, irrigation, municipal, manufacturing, industrial, etc.)

6. Description of Well: Depth 85 feet. Type Drilled
(Dug or drilled)
diameter 12 inches. Elevation of ground at well site _____ feet, mean sea level.
(As near as known)
Depth to water table _____ feet.

7. Capacity of Well: 100 g.p.m. with 50 feet drawdown.
_____ g.p.m. with _____ feet drawdown.


Date of test June 1, 1947

If Flowing Well: Measured discharge 100 g.p.m. on June 3, 1947
(Date)

Shut-in pressure at ground surface _____ lbs. per sq. in. on _____
(Date)

Water is controlled by _____
(Cap, valve, etc.)

Township T. 7S Range R. 2W, W.M.
North

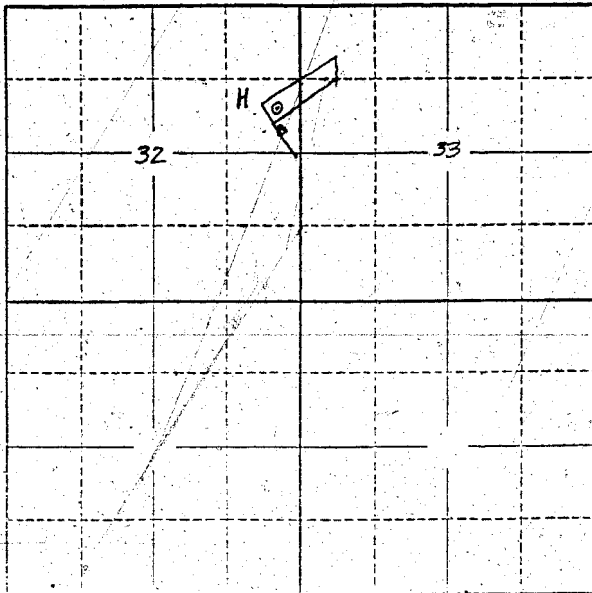

Locate well and acreage of irrigated land on plat.
Scale: 2" = 1 Mile

STATE OF OREGON

County of Marion

ss.

I, William Vogt, being first duly sworn, do hereby certify that I have read the foregoing Registration Statement and that all of the items therein contained are true to the best of my knowledge and belief.

William Vogt
(Signature of Registrant)

Subscribed and sworn to before me this 4th day of August, 1958

My commission expires 12th June 1961

Wm. S. Bartholomew
(Notary Public)

(SEAL)

CERTIFICATE OF REGISTRATION

STATE OF OREGON

County of Marion

ss.

This is to certify that the foregoing Registration Statement was received in the office of the State Engineer on the 4th day of August, 1958, at 12:15 o'clock A. M. and has been duly recorded in said office in Book No. 15 of Registration Statements on page OR-3595

~~X X Construction shall be completed by 1959 and the water completely applied to beneficial use by 1959~~

Witness my hand this 15th day of September, 1959

Lewis A. Stanley
(State Engineer)

\$1500

By

GR-3595

(Deputy)