

# Registration Statement

## OF CLAIMANT OF RIGHT TO APPROPRIATE GROUND WATER

TO THE STATE ENGINEER OF OREGON:

I, Virginia E. Claggett  
of Rt. 1 Box 403 County of Polk  
(Mailing address)

State of Oregon, do hereby make application for a certificate of registration as evidence of a right to appropriate ground water.

- 1. Source from which water is withdrawn is Pump well  
(Flowing well, pump well, infiltration trench, or tunnel)
- 2. Location is: 4 1/2 miles north of Salem  
(Approximate distance and direction from nearest city or town)

and is more particularly described as follows:

(a) North 1450' and West 860' from the SE corner of Sec. 32  
(Give distance and bearing to corner of section or other legal subdivision)  
being within NE 1/4 SE 1/4 of Sec. 32, Twp. 6 S, Rge. 3 W  
(Smallest legal subdivision) (N. or S.) (E. or W.)

or (b) within limits of recorded platted property, town or city:  
in Lot \_\_\_\_\_, Block \_\_\_\_\_ of \_\_\_\_\_  
(Name of plat or addition)  
County of \_\_\_\_\_  
(If within city or town, give name)

3. Construction Work was begun on May 2, 1954; was completed on May 13, 1954  
(Date) (Date)  
and the ground water claimed was first used for the purposes set out below on May 15, 1954  
(Date)  
since which time the water has been used Continuously  
(Continuously or intermittently)  
from 5/15/54 to Present  
(Date) (Date)

4. Quantity of water claimed and used is 20 gallons per minute; \_\_\_\_\_ acre feet per year.

5. Purpose or Purposes for which water is used Irrigation  
(Domestic, irrigation, municipal, manufacturing, industrial, etc.)

6. Description of Well: Depth 62 feet. Type Drilled  
(Dug or drilled)  
diameter 6 inches. Elevation of ground at well site 150' feet, mean sea level.  
(As near as known)  
Depth to water table 37 feet.


7. Capacity of Well: \_\_\_\_\_ g.p.m. with \_\_\_\_\_ feet drawdown.  
\_\_\_\_\_ g.p.m. with \_\_\_\_\_ feet drawdown.

Date of test \_\_\_\_\_  
If Flowing Well: Measured discharge \_\_\_\_\_ g.p.m. on \_\_\_\_\_  
(Date)  
Shut-in pressure at ground surface \_\_\_\_\_ lbs. per sq. in. on \_\_\_\_\_  
(Date)  
Water is controlled by \_\_\_\_\_  
(Cap, valve, etc.)





Township 6S Range 3W W.M.  
North

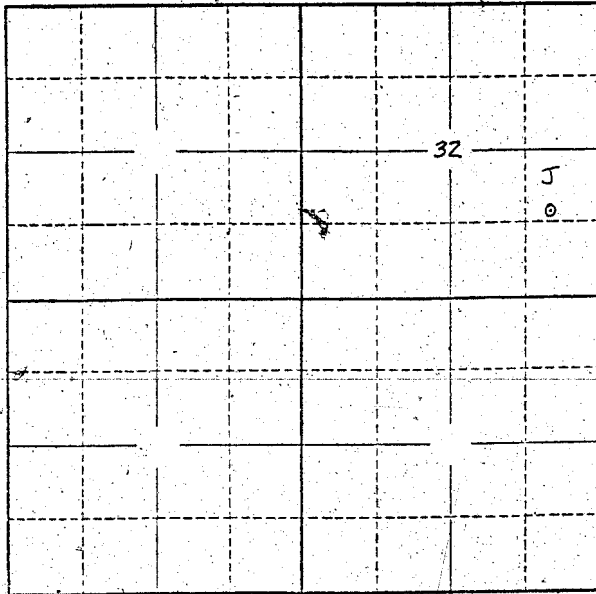

Locate well and acreage of irrigated land on plat.  
Scale: 2" = 1 Mile

STATE OF OREGON

County of Marion } ss.

I, Virginia E. Claggett, being first duly sworn, do hereby certify that I have read the foregoing Registration Statement and that all of the items therein contained are true to the best of my knowledge and belief.

Virginia E. Claggett  
(Signature of Registrant)

Subscribed and sworn to before me this 4th day of August, 1958

My commission expires 12th June 1961 Wm. D. Bartholomew  
(Notary Public)

(SEAL)

**CERTIFICATE OF REGISTRATION**

STATE OF OREGON } ss.  
County of Marion

This is to certify that the foregoing Registration Statement was received in the office of the State Engineer on the 4th day of August, 1958, at 1:30 o'clock P. M. and has been duly recorded in said office in Book No. 15 of Registration Statements on page GR-3596

Witness my hand this 15th day of September, 1959  
Lewis A. Stanley  
(State Engineer)

By \_\_\_\_\_ (Deputy)

\$15.00

GR 3596