

Registration Statement

OF CLAIMANT OF RIGHT TO APPROPRIATE GROUND WATER

TO THE STATE ENGINEER OF OREGON:

We, Walter D. Miller and Fernando M. Smith

of Starton County of Marion

(Mailing address)

State of Oregon, do hereby make application for a certificate of registration as evidence of a right to appropriate ground water.

1. Source from which water is withdrawn is Pump Well

(Flowing well, pump well, infiltration trench, or tunnel)

2. Location is: 2 miles south of Aumsville, Oregon on Aumsville, West Starton Road.

(Approximate distance and direction from nearest city or town)

and is more particularly described as follows:

(a) approximately 1000' South to 1/4 Section Corner common to Sections 1 & 12

(Give distance and bearing to corner of section or other legal subdivision)

being within SE 1/4 SW 1/4 of Sec. 1, Twp. 0 S, Rge. 2

(Smallest legal subdivision)

(N. or S.)

(E. or W.)

or (b) within limits of recorded platted property, town or city:

in Lot _____, Block _____ of _____

(Name of plat or addition)

County of Marion

(If within city or town, give name)

3. Construction Work was begun on June 1944; was completed on July 1944

(Date)

(Date)

and the ground water claimed was first used for the purposes set out below on July 1944

(Date)

since which time the water has been used intermittently

(Continuously or intermittently)

from July 1944 to August 1, 1950

(Date)

(Date)

4. Quantity of water claimed and used is 150 gallons per minute; _____ acre feet per year.

5. Purpose or Purposes for which water is used _____

Irrigation

(Domestic, irrigation, municipal, manufacturing, industrial, etc.)

6. Description of Well: Depth 38 feet. Type drilled

(Dug or drilled)

diameter _____ inches. Elevation of ground at well site appr. 251 feet, mean sea level.

(As near as known)

Depth to water table 2 feet.

7. Capacity of Well: _____ g.p.m. with _____ feet drawdown.

150 g.p.m. with 15' feet drawdown.

Date of test June, 1944

If Flowing Well: Measured discharge _____ g.p.m. on _____

(Date)

Shut-in pressure at ground surface _____ lbs. per sq. in. on _____


(Date)

Water is controlled by _____

(Cap, valve, etc.)

Township 9 S Range 2 W W.M.

North

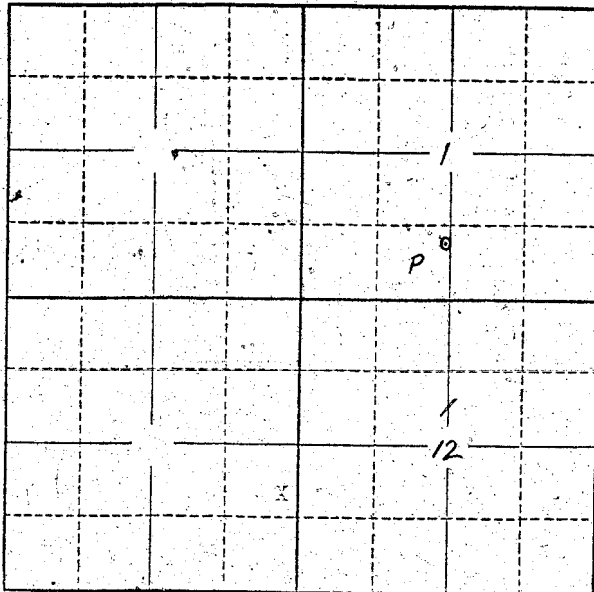

Locate well and acreage of irrigated land on plat.

Scale: 2" = 1 Mile

STATE OF OREGON

County of MARION } ss.

I, Walter D. Miller & Fernando M. Smith, being first duly sworn, do hereby certify that I have read the foregoing Registration Statement and that all of the items therein contained are true to the best of my knowledge and belief.

Walter D. Miller *Fernando M. Smith*
(Signature of Registrant)

Subscribed and sworn to before me this 1st day of _____, 19__

My commission expires Jan 25, 1959.

S. C. Bates
(Notary Public)

(SEAL)

S. C. Bates

CERTIFICATE OF REGISTRATION

STATE OF OREGON } ss.
County of Marion

This is to certify that the foregoing Registration Statement was received in the office of the State Engineer on the 4th day of August, 1958, at 8:00 o'clock A.M. and has been duly recorded in said office in Book No. 15 of Registration Statements on page GR-3597

Witness my hand this 15th day of September, 1959

Laura A. Stanley
(State Engineer)

By _____ (Deputy)

\$15.00

GR 3597