

Registration No. GR 3997

Certificate No. GR 3604

Registration Statement

OF CLAIMANT OF RIGHT TO APPROPRIATE GROUND WATER

TO THE STATE ENGINEER OF OREGON:

I, CHARLES R. ACHILLES

of Rt. 3 Box 425A Canby County of CLACKAMAS

State of OREGON, do hereby make application for a certificate of registration as evidence of a right to appropriate ground water.

1. Source from which water is withdrawn is PUMP WELL
(Flowing well, pump well, infiltration trench, or tunnel)

2. Location is: 1 MILE NORTH OF CANBY, OREGON
(Approximate distance and direction from nearest city or town)

and is more particularly described as follows: The Well is N 660' and E 150' and S 125' From the corner of 05 Sec. 28 - 3 - 1E

(a) ~~S10°30'W 850 Feet to Corner Point of Section 28~~
(Give distance and bearing to corner of section or other legal subdivision)

being within SW 1/4 of NE 1/4 of Sec. 28, Twp. 35, Rge. 1E
(Smallest legal subdivision) (N. or S.) (E. or W.)

or (b) within limits of recorded platted property, town or city:

in Lot 35, Block _____ of Pruneland
(Name of plat or addition)

County of Clackamas
(If within city or town, give name)

3. Construction Work was begun on June 1, 1946; was completed on July 1, 1946
(Date) (Date)

and the ground water claimed was first used for the purposes set out below on Aug. 1, 1946

since which time the water has been used for summer irrigation

from 1946 to 1958
(Date) (Date)
(Continuously or Intermittently)

quantity of water claimed and used is 50 gallons per minute; 4.8 acre feet per year.

5. Purpose or Purposes for which water is used IRRIGATION

(Domestic, irrigation, municipal, manufacturing, industrial, etc.)

6. Description of Well: Depth 84 feet. Type Drilled
(Dug or drilled)

diameter 6 inches. Elevation of ground at well site 100 feet, mean sea level.
(As near as known)

Depth to water table 47 feet.

7. Capacity of Well: 50 g.p.m. with 18 feet drawdown.

_____ g.p.m. with _____ feet drawdown.


Date of test 1946

If Flowing Well: Measured discharge _____ g.p.m. on _____
(Date)

Shut-in pressure at ground surface _____ lbs. per sq. in. on _____
(Date)

Water is controlled by _____
(Cap, valve, etc.)

Township 35 Range 1E W.M.
North

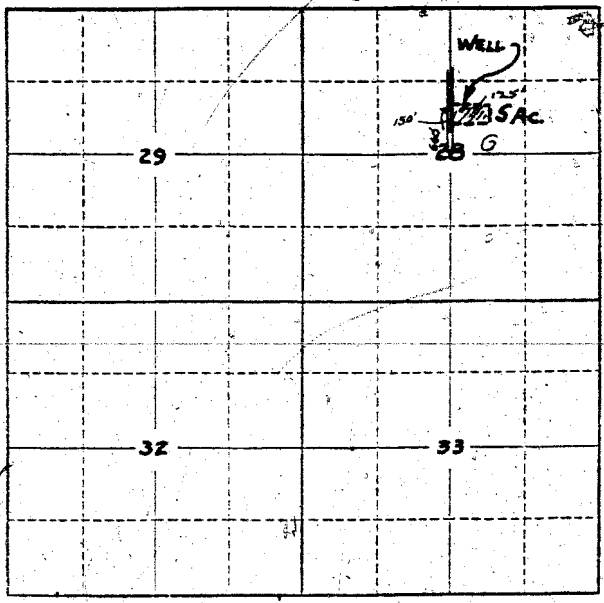

Locate well and acreage of irrigated land on plat.
Scale: 2" = 1 Mile

STATE OF OREGON

County of _____ } ss.

I, _____, being first duly sworn, do hereby certify that I have read the foregoing Registration Statement and that all of the items therein contained are true to the best of my knowledge and belief.

(Signature of Registrant)

Subscribed and sworn to before me this _____ day of _____, 19____

My commission expires _____
(Notary Public)

(SEAL)

CERTIFICATE OF REGISTRATION

STATE OF OREGON

County of Marion } ss.

This is to certify that the foregoing Registration Statement was received in the office of the State Engineer on the 4th day of August, 1952, at 2:05 o'clock P. M. and has been duly recorded in said office in Book No. 15 of Registration Statements on page GR-3604

Witness my hand this 15th day of September, 1959

(State Engineer)

By _____
(Deputy)

\$15.00

GR-3604