

Well #2

Registration No. GR-3999

Certificate No. GR-3606

# Registration Statement

## OF CLAIMANT OF RIGHT TO APPROPRIATE GROUND WATER

TO THE STATE ENGINEER OF OREGON:

I, Carl J. Walker  
of Route 3, Corvallis County of Denton  
(Mailing address)

State of Oregon, do hereby make application for a certificate of registration as evidence of a right to appropriate ground water.

1. Source from which water is withdrawn is pump well #2  
(Flowing well, pump well, infiltration trench, or tunnel)

2. Location is: Two miles east and north of Corvallis  
(Approximate distance and direction from nearest city or town)

and is more particularly described as follows:

(a) 300 feet N.W. corner of Section 7  
(Give distance and bearing to corner of section or other legal subdivision)  
being within NW 1/4 of SW 1/4 of Sec. 7, Twp. 13 S., Rge. 4 W.  
(Smallest legal subdivision) (S. or S.) (W. or W.)

or (b) within limits of recorded platted property, town or city;

in Lot \_\_\_\_\_, Block \_\_\_\_\_ of \_\_\_\_\_  
(Name of plat or addition)  
County of \_\_\_\_\_  
(If within city or town, give name)

3. Construction Work was begun on April 1951; was completed on May 1951  
(Date) (Date)

and the ground water claimed was first used for the purposes set out below on \_\_\_\_\_  
(Date)

since which time the water has been used intermittently  
(Continuously or intermittently)

from May 1951 to present  
(Date) (Date)

4. Quantity of water claimed and used is 100 gallons per minute; 25 acre feet per year.

5. Purpose or Purposes for which water is used irrigation  
(Domestic, irrigation, municipal, manufacturing, industrial, etc.)

6. Description of Well: Depth 36 feet. Type drilled  
(Dug or drilled)  
diameter 6 inches. Elevation of ground at well site \_\_\_\_\_ feet, mean sea level.  
(As near as known)  
Depth to water table 15 feet.

7. Capacity of Well: 500 g.p.m. with 20 feet drawdown.  
\_\_\_\_\_ g.p.m. with \_\_\_\_\_ feet drawdown.

Date of test May 1951

If Flowing Well: Measured discharge \_\_\_\_\_ g.p.m. on \_\_\_\_\_  
(Date)


Shut-in pressure at ground surface \_\_\_\_\_ lbs. per sq. in. on \_\_\_\_\_  
(Date)

Water is controlled by \_\_\_\_\_  
(Cap, valve, etc.)





Township 13 S Range 4 W W.M.  
North

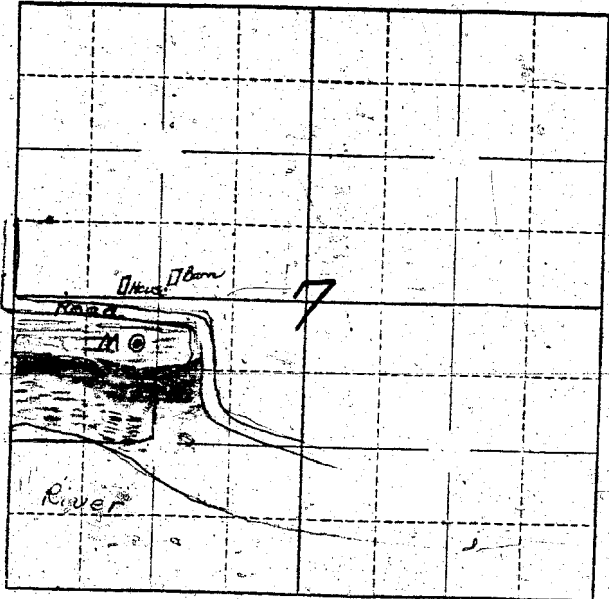

Locate well and acreage of irrigated land on plat.  
Scale:  $\frac{1}{2}$ " = 1 Mile

STATE OF OREGON  
County of Benton

— Brush  
— Irrigated Land  
SS.

I, Myrtle P. Mackey, being first duly sworn, do hereby certify that I have read the foregoing Registration Statement and that all of the items therein contained are true to the best of my knowledge and belief.

Myrtle P. Mackey  
(Signature of Registrant)

Subscribed and sworn to before me this 30 day of July, 1958

My commission expires 11-24-58

Cecil Barker  
(Notary Public)

(SEAL)

**CERTIFICATE OF REGISTRATION**

STATE OF OREGON }  
County of Marion } SS.

This is to certify that the foregoing Registration Statement was received in the office of the State Engineer on the 4 day of August, 1958, at 8:00 o'clock A.M. and has been duly recorded in said office in Book No. 15 of Registration Statements on page GR-3606

Witness my hand this 15<sup>th</sup> day of September, 1959

Laura A. Stanley  
(State Engineer)

\$16.50

By \_\_\_\_\_  
(Deputy)