

Registration Statement

OF CLAIMANT OF RIGHT TO APPROPRIATE GROUND WATER

(Under Chapter 708, Oregon Laws 1955.)

TO THE STATE ENGINEER OF OREGON:

I, Hugh G. Shields
of Sheridan County of Yamhill
State of Oregon, do hereby make application for a certificate of registration as evidence of a right to appropriate ground water.

1. Source from which water is withdrawn is pump well
(Flowing well, pump well, infiltration trench, or tunnel)
2. Location is: 3 1/2 miles southeast of Sheridan, on Sheridan - Belton road
(Approximate distance and direction from nearest city or town)

and is more particularly described as follows:

(a) 500' S and 130' W from center Sec 6
(Give distance and bearing to corner of section or other legal subdivision)
being within NE 1/4, SW 1/4 of Sec. 6, Twp. 6 S, Rge. 5 W
(Smallest legal subdivision) (N. or S.) (E. or W.)

or (b) within limits of recorded platted property, town or city:
in Lot _____, Block _____ of _____
(Name of plat or addition)

County of _____
(If within city or town, give name)

2. Construction Work was begun on Nov 3, 1952; was completed on Nov 3, 1952
(Date) (Date)

and the ground water claimed was first used for the purposes set out below on May 15, 1953
(Date)
since which time the water has been used intermittently
(Continuously or intermittently)

from May to Dec each year.
(Date) (Date)

4. Quantity of water claimed and used is 30 to 50 gallons per minute; _____ acre feet per year.

5. Purpose or Purposes for which water is used irrigation, domestic & livestock
(Domestic, irrigation, municipal, manufacturing, industrial, etc.)

6. Description of Well: Depth 14 feet. Type drilled
(Dug or drilled)

diameter 16 inches. Elevation of ground at well site 230' feet, mean sea level.
(As near as known)

Depth to water table 3' feet.

7. Capacity of Well: No tests g.p.m. with _____ feet drawdown.
_____ g.p.m. with _____ feet drawdown.


Date of test None

If Flowing Well: Measured discharge _____ g.p.m. on _____
(Date)

Shut-in pressure at ground surface _____ lbs. per sq. in. on _____
(Date)

Water is controlled by _____
(Cap, valve, etc.)

Township: 65 Range 5W W.M.
North

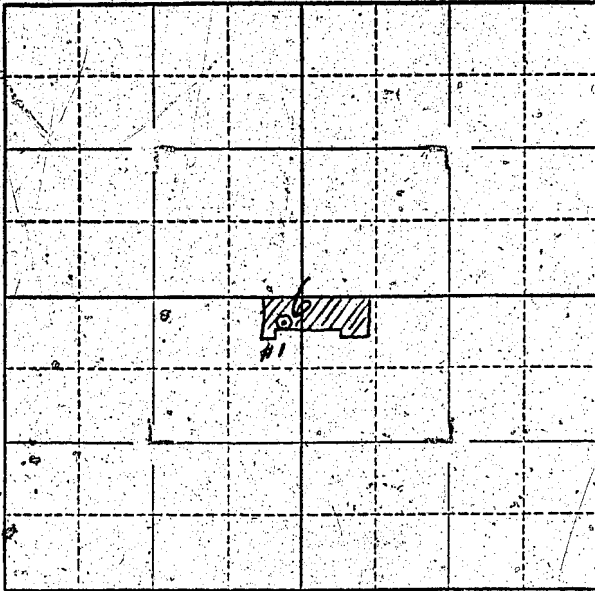

Locate well and acreage of irrigated land on plat.

Scale: $\frac{1}{4}$ " = 1 Mile

STATE OF OREGON

County of Marion } ss.

I, HUGH G. SHIELDS, being first duly sworn, do hereby certify that I have read the foregoing Registration Statement and that all of the items therein contained are true to the best of my knowledge and belief.

Hugh G. Shields
(Signature of Registrant)

Subscribed and sworn to before me this 15th day of November, 1955.

My commission expires Sept. 8, 1956

Chas. L. Wheeler
(Notary Public)

(SEAL)

CERTIFICATE OF REGISTRATION

STATE OF OREGON

County of Marion } ss.

For Certificate of Registration see Page GR-35 G

This is to certify that the foregoing Registration Statement was received in the office of the State Engineer on the 15th day of November, 1955, at 2:00 o'clock P.M. and has been duly recorded in said office in Book No. 1 of Registration Statements on page _____

Construction ^{is} ~~shall be~~ completed by _____, 19____, and the water ^{is} completely applied to beneficial use by _____, 19____.

Witness my hand this _____ day of _____, 19____.

Lewis A. Stanley
(State Engineer)

By _____
(Deputy)

Registration Statement

OF CLAIMANT OF RIGHT TO APPROPRIATE GROUND WATER

(Under Chapter 708, Oregon Laws 1955.)

TO THE STATE ENGINEER OF OREGON:

I, Hugh G. Shields

of Sheridan County of Yamhill

State of Oregon, do hereby make application for a certificate of registration as evidence of a right to appropriate ground water.

1. Source from which water is withdrawn is pump well
(Flowing well, pump well, infiltration trench, or tunnel)

2. Location is: 3 1/2 miles southeast of Sheridan or Sheridan-Belton road
(Approximate distance and direction from nearest city or town)

and is more particularly described as follows:

(a) 475' S and 720' E from center sec 6,
(Give distance and bearing to corner of section or other legal subdivision)

being within NW 1/4 SE 1/4 of Sec. 6, Twp. 6S, Rge. 5W
(Smallest legal subdivision) (N. or S.) (E. or W.)

or (b) within limits of recorded platted property, town or city:

in Lot _____, Block _____ of _____
(Name of plat or addition)

County of _____
(If within city or town, give name)

3. Construction Work was begun on May 27, 1954; was completed on May 27, 1954
(Date) (Date)

by Walter Dravin and the ground water claimed was first used for the purposes set out below on May 30, 1954
(Date)

since which time the water has been used intermittently
(Continuously or intermittently)

from May to now each year
(Date) (Date)

4. Quantity of water claimed and used is 30 to 50 gallons per minute; _____ acre feet per year.

5. Purpose or Purposes for which water is used irrigation & domestic & live stock
(Domestic, irrigation, municipal, manufacturing, industrial, etc.)

6. Description of Well: Depth 20 feet. Type drilled
(Dug or drilled)

diameter 1 1/2 inches. Elevation of ground at well site 230' feet, mean sea level.
(As near as known)

Depth to water table 7 3/4 feet.

7. Capacity of Well: No test g.p.m. with _____ feet drawdown.

_____ g.p.m. with _____ feet drawdown.


Date of test None

If Flowing Well: Measured discharge _____ g.p.m. on _____
(Date)

Shut-in pressure at ground surface _____ lbs. per sq. in. on _____
(Date)

Water is controlled by _____
(Cap, valve, etc.)

Township 6 S Range 5 W W.M.
North

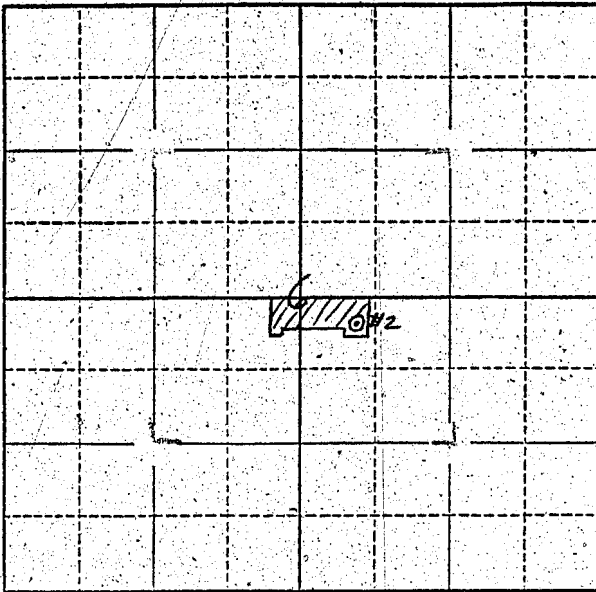

Locate well and acreage of irrigated land on plat.

Scale: $\frac{3}{4}$ " = 1 Mile
4" 2"

STATE OF OREGON

County of Marion } ss.

I, HUGH G. SHIELDS being first duly sworn, do hereby certify that I have read the foregoing Registration Statement and that all of the items therein contained are true to the best of my knowledge and belief.

Hugh G. Shields
(Signature of Registrant)

Subscribed and sworn to before me this 15th day of November, 1955.

My commission expires Sept 8, 1956

Chris T. ...
(Notary Public)

(SEAL)

CERTIFICATE OF REGISTRATION

STATE OF OREGON

County of Marion } ss.

This is to certify that the foregoing Registration Statement was received in the office of the State Engineer on the 15th day of November, 1955, at 2:00 o'clock P.M. and has been duly recorded in said office in Book No. 1 of Registration Statements on page 35.

Construction shall be completed by 15, 1955, and the water completely applied to beneficial use by 19.

Witness my hand this 24th day of February, 1956.

Lewis A. Stanley
(State Engineer)

By _____ (Deputy)