

Registration Statement

OF CLAIMANT OF RIGHT TO APPROPRIATE GROUND WATER

TO THE STATE ENGINEER OF OREGON:

I, Fred and Dena Hanni
 of Rt 3 Box 111 Oregon City County of Clackamas
(Mailing address)
 State of Oregon, do hereby make application for a certificate of registration as evidence of a right to appropriate ground water.

1. Source from which water is withdrawn is Pump Well
(Flowing well, pump well, infiltration trench, or tunnel)

2. Location is: 2 miles Southeast Oregon City
(Approximate distance and direction from nearest city or town)

and is more particularly described as follows: about 880 feet South & 750 feet West from NE corner Section 8,

(a) Clairmont Acreage No. 3, lot 2-3, Plat 277
(Give distance and bearing to corner of section or other legal subdivision)

being within Northeast Quarter of Sec. 8 Twp. 35 Rge. 2E
(Smallest legal subdivision) or S. (E.)

or (b) within limits of recorded platted property, town or city:

in Lot 2-3, Block _____ of Clairmont Acreage No. 3, Plat 277
(Name of plat or addition)

County of Clackamas
(If within city or town, give name)

3. Construction Work was begun on Aug 24, 1953; was completed on Sept. 1, 1953
(Date) (Date)

and the ground water claimed was first used for the purposes set out below on August 10, 1956
(Date)

since which time the water has been used Intermittently
(Continuously or Intermittently)

from Aug. 10, 1956 to July 30, 1958
(Date) (Date)

4. Quantity of water claimed and used is 16 gallons per minute; 5 acre feet per year.

5. Purpose or Purposes for which water is used ~~Domestic~~ irrigation
(Domestic, irrigation, municipal, manufacturing, industrial, etc.)

6. Description of Well: Depth 300 feet. Type Drilled
(Dug or drilled)
 diameter 6 inches. Elevation of ground at well site 400 feet, mean sea level.
(As near as known)

Depth to water table 200 feet.

7. Capacity of Well: 18 g.p.m. with 25 feet drawdown.

_____ g.p.m. with _____ feet drawdown.


Date of test Sept 1, 1953

If Flowing Well: Measured discharge _____ g.p.m. on _____
(Date)

Shut-in pressure at ground surface _____ lbs. per sq. in. on _____
(Date)

Water is controlled by _____
(Cap, valve, etc.)

Township 35 Range 2E W.M.
Sec. 7 North Sec. 8

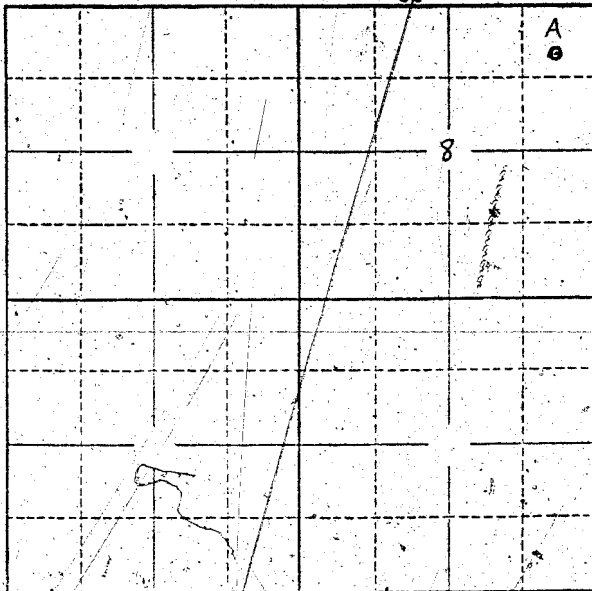

Locate well and acreage of irrigated land on plat.
Scale: 2" = 1 Mile

STATE OF OREGON

County of _____ } ss.

I, _____, being first duly sworn, do hereby certify that I have read the foregoing Registration Statement and that all of the items therein contained are true to the best of my knowledge and belief.

(Signature of Registrant)

Subscribed and sworn to before me this _____ day of _____, 19____.

My commission expires _____

(Notary Public)

(SEAL)

CERTIFICATE OF REGISTRATION

STATE OF OREGON

County of Marion } ss.

This is to certify that the foregoing Registration Statement was received in the office of the State Engineer on the 27th day of August, 1952, at 2:00 o'clock A. M. and has been duly recorded in said office in Book No. 15 of Registration Statements on page GR 3607

Witness my hand this 15th day of September, 1952

Lewis A. Stanley
(State Engineer)

By _____
(Deputy)

GR 3607

15.00