

# Registration Statement

## OF CLAIMANT OF RIGHT TO APPROPRIATE GROUND WATER

TO THE STATE ENGINEER OF OREGON:

I, Joseph H. Bates

of 4555 N. W. 191st Ave., Aloha, Oregon County of Washington

State of Oregon, do hereby make application for a certificate of registration as evidence of a right to appropriate ground water.

1. Source from which water is withdrawn is Pump well  
(Flowing well, pump well, infiltration trench, or tunnel)

2. Location is: one mile southwest of Aloha  
(Approximate distance and direction from nearest city or town)

and is more particularly described as follows: 1750 ft. west, 1450 ft. south from NE corner Section 13.

(a) Part of Lot 6 of Wheeler's Subdivision as described in Book 309, page 407 and Book 323 (Give distance and bearing to corner of section or other legal subdivision)  
being within S. 24. 44 of N. E. 74 - 263 of Sec. 13, Twp. 1 S, Rge. 2 W  
(Smallest legal subdivision) (N. or S.) (E. or W.)

or (b) within limits of recorded platted property, town or city:

in Lot 6 Block \_\_\_\_\_ of Wheeler's Subdivision  
(Name of plat or addition)

County of Washington  
(If within city or town, give name)

3. Construction Work was begun on May 14, 1952; was completed on June 14, 1952  
(Date) (Date)

and the ground water claimed was first used for the purposes set out below on June 14, 1952  
(Date)

since which time the water has been used continuously  
(Continuously or intermittently)

from June 14, 1952 to July 29, 1958  
(Date) (Date)

4. Quantity of water claimed and used is eight gallons per minute; 3.75 acre feet per year.

5. Purpose or Purposes for which water is used Irrigation

(Domestic, irrigation, municipal, manufacturing, industrial, etc.)

6. Description of Well: Depth 125 feet. Type Drilled  
(Dug or drilled)

diameter 6 inches. Elevation of ground at well site \_\_\_\_\_ feet, mean sea level.  
(As near as known)

Depth to water table 80 feet.

7. Capacity of Well: 8 g.p.m. with 70 feet drawdown.

\_\_\_\_\_ g.p.m. with \_\_\_\_\_ feet drawdown.

Date of test not tested - will run sprinklers during 8 p.m.

If Flowing Well: Measured discharge \_\_\_\_\_ g.p.m. on \_\_\_\_\_  
(Date)

Shut-in pressure at ground surface \_\_\_\_\_ lbs. per sq. in. on \_\_\_\_\_  
(Date)

Water is controlled by \_\_\_\_\_  
(Cap, valve, etc.)

8. Casing: (Give diameter, commercial specifications and depth below ground surface of each casing size.)

6 inch diameter from 0 to 110 feet  
inch diameter from to feet  
inch diameter from to feet  
inch diameter from to feet

Describe and show depth of shoe, plug, adapter, liner or other details: *Liner goes down to about 112 feet.*

9. Perforated Casings or Screens:

*none* from to  
(Number per foot and size of perforations, or describe screen)  
from to  
from to  
from to

10. Log of Well: (Describe each stratum or formation clearly, indicate if water bearing, and give thickness and depth as indicated.)

MATERIAL	Thickness (Feet)	Depth to Bottom (Feet)
Soil	20	105
Blue clay	92	13
Rock	13	0

If log of well is not available, give name and address of driller. A. J. Stewart,

Alaska, Oregon

11. Infiltration Trench: Covered or open \_\_\_\_\_  
 Dimensions: Length \_\_\_\_\_ ft. Minimum depth \_\_\_\_\_ ft. Maximum depth \_\_\_\_\_ ft.  
 Bottom width \_\_\_\_\_ ft. Discharge \_\_\_\_\_ g.p.m. Date of test \_\_\_\_\_

12. Tunnel: Type of lining \_\_\_\_\_  
 Dimensions: \_\_\_\_\_  
(Length, course, and cross sectional size)  
 Position of water bearing stratum with reference to portal of tunnel \_\_\_\_\_

Log of tunnel: (Preceding table for log of well may be used, if desired. Give footage from portal and character of materials, as pertinent.)

13. Pumping Equipment:  
 (a) Pump Fairbanks Morse, centrifugal, 1 hp Capacity 580 g.p.m.  
(Make, type and size)  
 (b) Motor Fairbanks Morse, 1 hp  
(Type and horsepower)


14. Location of area irrigated or to be irrigated, or place of use if for purposes other than irrigation.

Township North or South	Range E. or W. of Willamette Meridian	Section	Forty-acre Tract	Number Acres To Be Irrigated	Date of Reclamation
<u>S 1</u>	<u>2 N</u>	<u>13</u>	<u>SW 1/4 of NE 1/4</u>	<u>1 1/2</u>	<u>1952</u>

15. If the ground water supply is supplemental to an existing water supply, identification of any application for a permit, permit, certificate or adjudicated right to appropriate water made or held by the registrant.  
We use city water for domestic purposes.

Township 1 S Range 2 W, W.M.

North

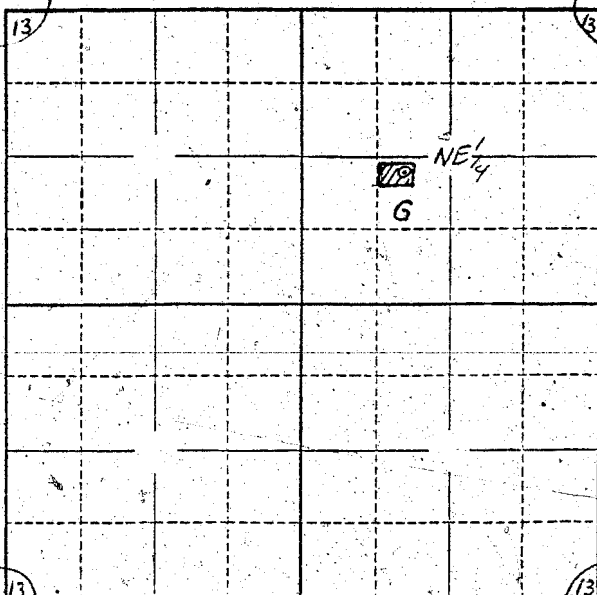

Locate well and acreage of irrigated land on plat.

Scale: 2" = 1 Mile

STATE OF OREGON

County of Washington

} ss.

I, Joseph W. Bates, being first duly sworn, do hereby certify that I have read the foregoing Registration Statement and that all of the items therein contained are true to the best of my knowledge and belief.

Joseph W. Bates  
(Signature of Registrant)

Subscribed and sworn to before me this 29<sup>th</sup> day of July, 1958

My commission expires 6-14-61

Paul H. Knapp  
(Notary Public)

(SEAL)

**CERTIFICATE OF REGISTRATION**

STATE OF OREGON

County of Marion

} ss.

This is to certify that the foregoing Registration Statement was received in the office of the State Engineer of the 4<sup>th</sup> day of August, 1958, at 9:00 o'clock A.M. and has been duly recorded in said office in Book No. 15 of Registration Statements on page GR-3608

Witness my hand this 15<sup>th</sup> day of September, 1959

Clara A. Stanley  
(State Engineer)

By \_\_\_\_\_

(Deputy)

GR 3608