

Registration Statement

OF CLAIMANT OF RIGHT TO APPROPRIATE GROUND WATER

(Under Chapter 708, Oregon Laws 1955.)

TO THE STATE ENGINEER OF OREGON:

I, Elmer M. Schweitzer 621 N. Summer

of Portland County of Multnomah

State of Oregon, do hereby make application for a certificate of registration as evidence of a right to appropriate ground water.

1. Source from which water is withdrawn is Flowing well
(Flowing well, pump well, infiltration trench, or tunnel)

2. Location is: 7 miles from 92nd St. Portland Ore. on Foster Road
(Approximate distance and direction from nearest city or town)

and is more particularly described as follows:

(a) 2350 ft. W. of S.E. corner of Sec. 5
(Give distance and bearing to corner of section or other legal subdivision)

being within S.W. 1/4 of S.E. 1/4 of Sec. 5, Twp. 33 Rge. 1 E
(Smallest legal subdivision) (N. or S.) (E. or W.)

or (b) within limits of recorded platted property, town or city:

in Lot _____, Block _____ of _____
(Name of plat or addition)

County of _____
(If within city or town, give name)

3. Construction Work was begun on 6/46; was completed on 6/46
(Date) (Date)

and the ground water claimed was first used for the purposes set out below on 8/49
(Date)

since which time the water has been used used continuously
(Continuously or Intermittently)

from 1949 to 1958
(Date) (Date)

4. Quantity of water claimed and used is 50 gallons per minute; _____ acre feet per year.

5. Purpose or Purposes for which water is used irrigation
(Domestic, irrigation, municipal, manufacturing, industrial, etc.)

6. Description of Well: Depth 100 feet. Type drilled well
(Dug or drilled)

diameter 8 inches. Elevation of ground at well site 140 feet, mean sea level.
(As near as known)

Depth to water table 50 feet.

7. Capacity of Well: 50 g.p.m. with 70 feet drawdown.

_____ g.p.m. with _____ feet drawdown.


Date of test 6/46

If Flowing Well: Measured discharge _____ g.p.m. on _____
(Date)

Shut-in pressure at ground surface _____ lbs. per sq. in. on _____
(Date)

Water is controlled by _____
(Cap, valve, etc.)

Township S 5 Range S 5 W.M.
North

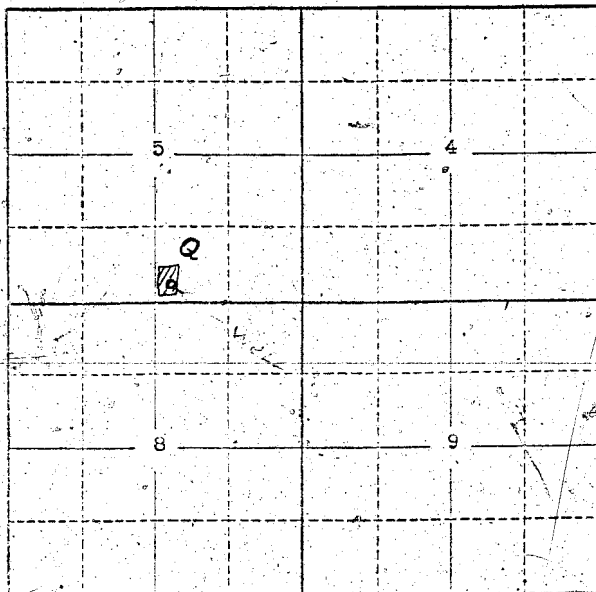

Locate well and acreage of irrigated land on plat.
Scale: 2" = 1 Mile

STATE OF OREGON

County of Washington ss.

I, Edmond M. Schuchter, being first duly sworn, do hereby certify that I have read the foregoing Registration Statement and that all of the items therein contained are true to the best of my knowledge and belief.

Edmond M. Schuchter
(Signature of Registrant)

Subscribed and sworn to before me this 31st day of July, 1956

My commission expires May 23, 1959

Elizabeth L. Lister
(Notary Public)

(SEAL)

CERTIFICATE OF REGISTRATION

STATE OF OREGON

County of Marion ss.

This is to certify that the foregoing Registration Statement was received in the office of the State Engineer on the 4 day of August, 1958, at 8:00 o'clock A. M. and has been duly recorded in said office in Book No. 15 of Registration Statements on page GR-3609

~~Construction shall be completed by _____ and the water completely applied to beneficial use by _____~~

Witness my hand this 15th day of September, 1959

Laura A. Stanley
(State Engineer)

By _____

(Deputy)

\$15.00

GR-3609