RECEIVED
MAR 1
STATE ENGINEER
SALEM, OREGON

REGISTRATION NO. GR-401
CERTIFICATE NO. GR 404

Registration Statement

OF CLAIMANT OF RIGHT TO APPROPRIATE GROUND WATER

(Under Chapter 708, Oregon Laws 1955.)

TO THE STATE ENGINEER OF OREGON:

I, O. A. Hall, P.O. Box 54,

of Oregon City County of Marion

State of Oregon, do hereby make application for a certificate of registration as evidence of a right to appropriate ground water.

1. **Source** from which water is withdrawn is Pump (Flowing well, pump well, infiltration trench, or tunnel).

2. **Location is:** 2 miles East of Jefferson Marion Co.; (Approximate distance and direction from nearest city or town)

and is more particularly described as follows:

(a) 340 feet west and 600 feet south from N 1/4 corner (Give distance and bearing to corner of section or other legal subdivision)

being within NE 1/4 of NW 1/4 (Smallest legal subdivision) of Sec. 6, Twp. 10 S (N. or S.), Rge. 2 W (E. or W.)

or (b) within limits of recorded platted property, town or city: .....

in Lot ....., Block ..... of ..... (Name of plat or addition)

..... (If within city or town, give name) County of .....

3. **Construction Work** was begun on Sept. 1952 (Date); was completed on 1952 (Date)

and the ground water claimed was first used for the purposes set out below on 1952 (Date),

since which time the water has been used continuously during season (Continuously or intermittently)

from 1952 (Date) to Oct. 30 1957 (Date) (present)

4. **Quantity** of water claimed and used is 230 gallons per minute; ..... acre feet per year.

5. **Purpose or Purposes** for which water is used Irrigation

..... (Domestic, irrigation, municipal, manufacturing, industrial, etc.)

6. **Description of Well:** Depth 22 feet. Type Drilled (Dug or drilled)

diameter 10 inches. Elevation of ground at well site 255 (As near as known) feet, mean sea level.

Depth to water table 6 feet.

7. **Capacity of Well:** 200 g.p.m. with 12 feet drawdown.

..... g.p.m. with ..... feet drawdown.

Date of test .....

If Flowing Well: Measured discharge ..... g.p.m. on ..... (Date)

Shut-in pressure at ground surface ..... lbs. per sq. in. on ..... (Date)

Water is controlled by ..... (Cap, valve, etc.)

8. **Casing:** (Give diameter, commercial specifications and depth below ground surface of each casing size.)

10 inch diameter from 0 to 22 feet

..... inch diameter from ..... to ..... feet

..... inch diameter from ..... to ..... feet

..... inch diameter from ..... to ..... feet

Describe and show depth of shoe, plug, adapter, liner or other details: .....

9. **Perforated Casings or Screens:**

perforated from 10 to 22
(Number per foot and size of perforations, or describe screen)

..... from ..... to .....

..... from ..... to .....

..... from ..... to .....

10. **Log of Well:** (Describe each stratum or formation clearly, indicate if water bearing, and give thickness and depth as indicated.)

MATERIAL	Thickness (Feet)	Depth to Bottom (Feet)
Topsoil	0	8
Gravel	8	22

If log of well is not available, give name and address of driller. Myron West

X 11. **Infiltration Trench:** Covered or open .....

Dimensions: Length ..... ft. Minimum depth ..... ft. Maximum depth ..... ft.

Bottom width ..... ft. Discharge ..... g.p.m. Date of test .....

X 12. **Tunnel:** Type of lining .....

Dimensions: .....
(Length, course, and cross sectional size)

Position of water bearing stratum with reference to portal of tunnel .....

Log of tunnel: (Preceding table for log of well may be used, if desired. Give footage from portal and character of materials, as pertinent.)

13. **Pumping Equipment:**

(a) Pump Fairbanks - Morse (Make, type and size) Capacity 350 g.p.m.

(b) Motor 10 HP (Type and horsepower)

14. Location of area irrigated or to be irrigated, or place of use if for purposes other than irrigation.

Township North or South	Range E. or W. of Willamette Meridian	Section	Forty-acre Tract	Number Acres To Be Irrigated	Date of Reclamation
10 S	2 W.	6	NE 1/4 of the NW 1/4	25	1952
"	"	6	NW 1/4 of the NW 1/4	5	1952

15. If the ground water supply is supplemental to an existing water supply, identification of any application for a permit, permit, certificate or adjudicated right to appropriate water made or held by the registrant.

Sec. 6
NW¼

600' South of N line
+
1000' East of W. line.

Located in E½ of the NW¼ of Sec. 6-10-2W

Township 10 Range 2 W, W.M.

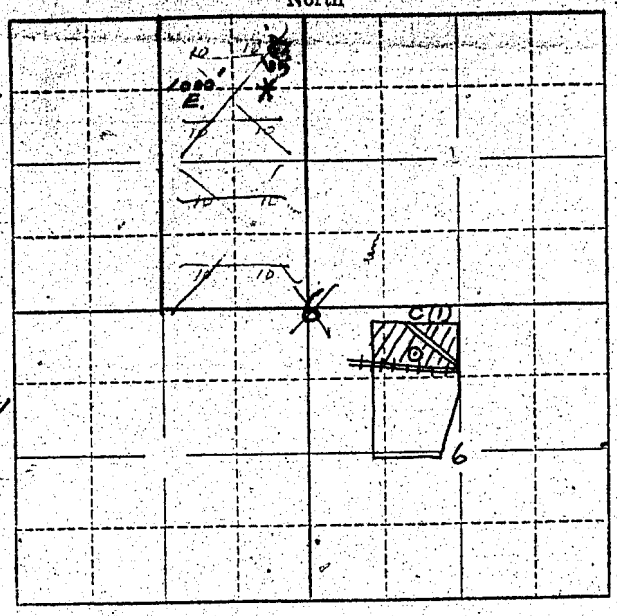

Locate well and acreage of irrigated land on plat.

Scale: ~~2"~~ 4" = 1 Mile

STATE OF OREGON
County of Marion } ss.

I, O. A. Hall, being first duly sworn, do hereby certify that I have read the foregoing Registration Statement and that all of the items therein contained are true to the best of my knowledge and belief.

O. A. Hall
(Signature of Registrant)

Subscribed and sworn to before me this 7th day of March, 1957.

My commission expires MY COMMISSION EXPIRES JULY 25, 1960
Gladys A. Shields
(Notary Public)

(SEAL)

CERTIFICATE OF REGISTRATION

STATE OF OREGON
County of Marion } ss.

This is to certify that the foregoing Registration Statement was received in the office of the State Engineer on the 18th day of March, 19 57, at 8:00 o'clock A. M. and has been duly recorded in said office in Book No. 3 of Registration Statements on page GR-404 C

~~Construction shall be completed by x-x-x-x-x-x-x-x-x-x-x-19-x-x and the water completely applied to beneficial use by x-x-x-x-x-x-x-x-x-x-19-x-x~~

Witness my hand this 26th day of June, 19 57.

Lewis A. Stanley
(State Engineer)

By
(Deputy)

#15.00

404 C