

Registration Statement

OF CLAIMANT OF RIGHT TO APPROPRIATE GROUND WATER

TO THE STATE ENGINEER OF OREGON:

I, DAVID T O'CONNOR
of SUMMER LAKE County of LAKE
(Mailing address)

State of OREGON, do hereby make application for a certificate of registration as evidence of a right to appropriate ground water.

- 1. Source from which water is withdrawn is FLOWING WELL (Capped)
(Flowing well, pump well, infiltration trench, or tunnel)
- 2. Location is: 1/2 Miles South of Summer Lake
(Approximate distance and direction from nearest city or town)

and is more particularly described as follows:

(a) 1220' South & 1500' WEST FROM NE COR. SEC 15
(Give distance and bearing to corner of section or other legal subdivision)
being within NW & NE of Sec. 15, Twp. 31S, Rge. 16E
(Smallest legal subdivision) (N. or S.) (E. or W.)

or (b) within limits of recorded platted property, town or city:
in Lot _____, Block _____ of _____
(Name of plat or addition)

County of LAKE
(If within city or town, give name)

3. Construction Work was begun on SPRING 1924; was completed on Summer 1924
(Date) (Date)

and the ground water claimed was first used for the purposes set out below on SUMMER (July? 1924)
(Date)
since which time the water has been used Domestic (Continuously) stock water irrigation
(Continuously or intermittently)
from 1924 to 1966
(Date) (Date)

4. Quantity of water claimed and used is 20 gallons per minute; _____ acre feet per year.

5. Purpose or Purposes for which water is used Domestic, stock water and irrigation
(Domestic, irrigation, municipal, manufacturing, industrial, etc.)

6. Description of Well: Depth ? feet. Type Drilled
(Dug or drilled)
diameter 6 inches. Elevation of ground at well site 4175 ± feet, mean sea level.
(As near as known)
Depth to water table _____ feet.

7. Capacity of Well: 20 g.p.m. with 0 feet drawdown.
_____ g.p.m. with _____ feet drawdown.


Date of test _____

If Flowing Well: Measured discharge 20 g.p.m. on _____
(Date)

Shut-in pressure at ground surface _____ lbs. per sq. in. on _____
(Date)

Water is controlled by Valve
(Cap, valve, etc.)

Township 315 Range 16E, W.M.
North

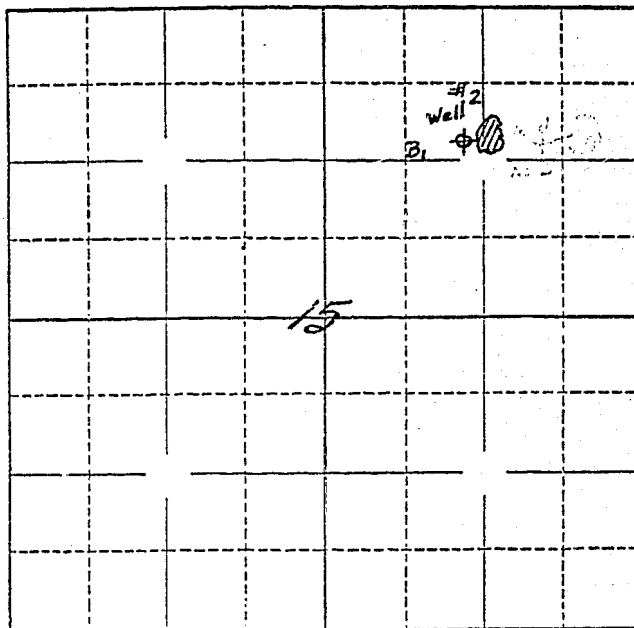

Locate well and acreage of irrigated land on plat.

Scale: 2" = 1 Mile

STATE OF OREGON

County of Lake } ss.

I, DAVID T O'CONNOR, being first duly sworn, do hereby certify that I have read the foregoing Registration Statement and that all of the items therein contained are true to the best of my knowledge and belief.

David T O'Connor
(Signature of Registrant)

Subscribed and sworn to before me this 3rd day of May, 1966

My commission expires 9-10-66 Barbara Snider
(Notary Public)

(SEAL)

CERTIFICATE OF REGISTRATION

STATE OF OREGON }
County of Marion } ss.

This is to certify that the foregoing Registration Statement was received in the office of the State Engineer on the 4th day of August, 1958, at 8:00 o'clock A. M. and has been duly recorded in said office in Book No. 17 of Registration Statements on page GR-4137

Witness my hand this 10th day of May, 1966

Chas L. Wheeler
(State Engineer)

By _____
(Deputy)

GR 4137