

Registration Statement

STATE OF OREGON OFFICE OF CLAIMANT OF RIGHT TO APPROPRIATE GROUND WATER

FEB 11 1930
STATE ENGINEER
SALE OFFICE

TO THE STATE ENGINEER OF OREGON:

I, GUS PRETZ

of RT. 5, Box 774, OREGON CITY, County of CLACKAMAS

State of OREGON, do hereby make application for a certificate of registration as evidence of a right to appropriate ground water.

1. Source from which water is withdrawn is PUMP WELL
(Flowing well, pump well, infiltration trench, or tunnel)

2. Location is: 1 MILE EAST OF PARK PLACE
(Approximate distance and direction from nearest city or town)

and is more particularly described as follows:

(a) N 61° W, 2950 FEET FROM S.E. COR. SEC. 21
(Give distance and bearing to corner of section or other legal subdivision)

being within NW 1/4 SE 1/4 of Sec. 21, Twp. 25, Rge. 3E
(Smallest legal subdivision) (N. or S.) (E. or W.)

or (b) within limits of recorded platted property, town or city:

in Lot _____, Block _____ of _____
(Name of plat or addition)

County of Clackamas
(If within city or town, give name)

3. Construction Work was begun on 1922; was completed on 1922
(Date) (Date)

and the ground water claimed was first used for the purposes set out below on 1945 22
(Date)

since which time the water has been used Continuously
(Continuously or Intermittently)

from 1945 1922 to 1952
(Date) (Date)

4. Quantity of water claimed and used is 15 gallons per minute; _____ acre
feet per year. (exempt)

5. Purpose or Purposes for which water is used irrigation
(Domestic, irrigation, municipal, manufacturing, industrial, etc.)

6. Description of Well: Depth app. 365 feet. Type drilled
(Dug or drilled)

diameter 6 inch inches. Elevation of ground at well site _____ feet, mean sea level.
(As near as known)

Depth to water table app. A.C.D. feet.

7. Capacity of Well: _____ g.p.m. with _____ feet drawdown.

_____ g.p.m. with _____ feet drawdown.

Date of test _____


If Flowing Well: Measured discharge _____ g.p.m. on _____
(Date)

Shut-in pressure at ground surface _____ lbs. per sq. in. on _____
(Date)

Water is controlled by VALVE
(Cap, valve, etc.)

This property was purchased by us in 1945 and the well was in use during year 1945 that so there were some questions on whether we cannot answer. But the well was not

Township 25 Range 2E, W.M.
North

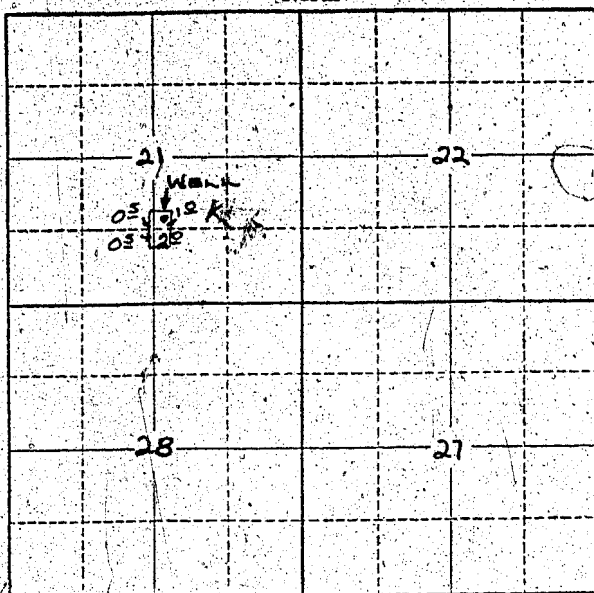

Locate well and acreage of irrigated land on plat.
Scale: 2" = 1 Mile

STATE OF OREGON

County of Wasco } ss.

I, Gene Plets, being first duly sworn, do hereby certify that I have read the foregoing Registration Statement and that all of the items therein contained are true to the best of my knowledge and belief.

Gene Plets
(Signature of Registrant)

Subscribed and sworn to before me this 1st day of August, 1956

My commission expires Sept 26 1959 M. C. Standberg
(Notary Public)

(SEAL)

CERTIFICATE OF REGISTRATION

STATE OF OREGON

County of Marion } ss.

This is to certify that the foregoing Registration Statement was received in the office of the State Engineer on the 4th day of August, 1958, at 2.00 o'clock A. M. and has been duly recorded in said office in Book No. 16 of Registration Statements on page GR 3961

Witness my hand this 15th day of February, 1960

Leura A. Stanley
(State Engineer)

By _____ (Deputy)

\$15.00