

# Registration Statement

## OF CLAIMANT OF RIGHT TO APPROPRIATE GROUND WATER

TO THE STATE ENGINEER OF OREGON:

I, Wayne Hayes  
 of 535 Coburn Road County of Lane  
(Mailing address)  
 State of Oregon, do hereby make application for a certificate of registration as evidence of a right to appropriate ground water.

1. Source from which water is withdrawn is Driven Well  
(Flowing well, pump well, infiltration trench, or tunnel)

2. Location is: 1/2 Mile East of Eugene Oregon  
(Approximate distance and direction from nearest city or town)

and is more particularly described as follows: 965 feet south & 875 feet west of NE Cor. of SE 1/4 of NW 1/4 of Section 29.

(a) 1320 ft. South & 614 ft. West of S.E. Cor. D.L.C. 53  
(Give distance and bearing to corner of section or other legal subdivision)

being within SE 1/4 of NW 1/4 of Sec. 29, Twp. 17 S, Rge. 3 W  
(Smallest legal subdivision) (Refer S.) (Refer W.)

or (b) within limits of recorded platted property, town or city:

in Lot \_\_\_\_\_, Block \_\_\_\_\_ of \_\_\_\_\_  
(Name of plat or addition)

County of Lane

(If within city or town, give name)

3. Construction Work was begun on March 1 - 1940, was completed on June 1 - 1940  
(Date) (Date)

and the ground water claimed was first used for the purposes set out below on June 1 - 1940  
(Date)

since which time the water has been used Cash Irrigation Season  
(Continuously or intermittently)

from May to October  
(Date) (Date)

4. Quantity of water claimed and used is 150 gallons per minute; \_\_\_\_\_ acre feet per year.

5. Purpose or Purposes for which water is used Irrigation of Cannery and Seed Crops  
(Domestic, irrigation, municipal, manufacturing, industrial, etc.)

6. Description of Well: Depth 28 feet. Type Driven  
(Dug or drilled)

diameter 2 inches. Elevation of ground at well site 4.29 feet, mean sea level.  
(As near as known)

Depth to water table 16 feet.

7. Capacity of Well: 150 g.p.m. with 20 feet drawdown.

\_\_\_\_\_ g.p.m. with \_\_\_\_\_ feet drawdown.

Date of test May 1940

If Flowing Well: Measured discharge \_\_\_\_\_ g.p.m. on \_\_\_\_\_  
(Date)


Shut-in pressure at ground surface \_\_\_\_\_ lbs. per sq. in. on \_\_\_\_\_  
(Date)

Water is controlled by \_\_\_\_\_  
(Cap, valve, etc.)





Township 17.5, Range 3W, W.M.  
North

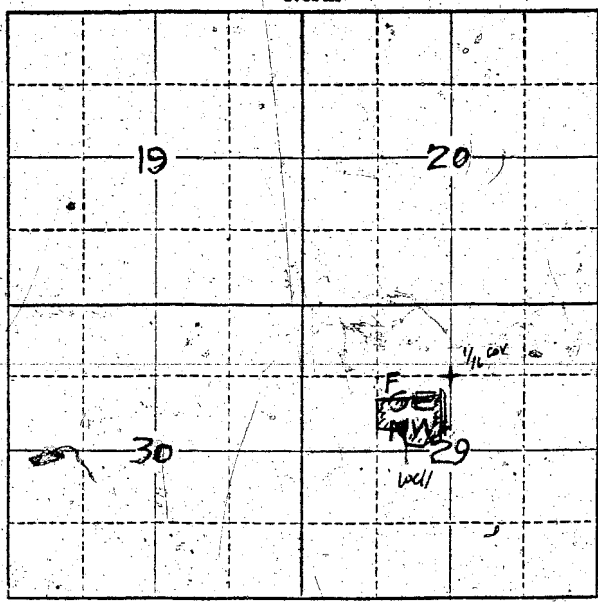

Locate well and acreage of irrigated land on plat.  
Scale: 2" = 1 Mile

STATE OF OREGON }  
County of Hamilton } ss.

I, WALTER HAYES, being first duly sworn, do hereby certify that I have read the foregoing Registration Statement and that all of the items therein contained are true to the best of my knowledge and belief.

Walter Hayes  
(Signature of Registrant)

Subscribed and sworn to before me this 1st day of August, 1958

My commission expires CHARLES W. ROFFE  
(Notary Public)

My Commission Expires June 24, 1961

(SEAL)

**CERTIFICATE OF REGISTRATION**

STATE OF OREGON }  
County of Marion } ss.

This is to certify that the foregoing Registration Statement was received in the office of the State Engineer on the 4th day of August, 1958, at 1:00 o'clock P.M. and has been duly recorded in said office in Book No. 15 of Registration Statements on page GR-3621

Witness my hand this 15th day of September, 1959

Lewis A. Stanley  
(State Engineer)

By \_\_\_\_\_  
(Deputy)

\$15.00

GR 3621