RECEIVED
MAR 1 9 1957
STATE ENGINEER
SALEM, OREGON

REGISTRATION NO. GR-402
CERTIFICATE NO. GR 385

Registration Statement

OF CLAIMANT OF RIGHT TO APPROPRIATE GROUND WATER

(Under Chapter 708, Oregon Laws 1955.)

TO THE STATE ENGINEER OF OREGON:

I, George Settlemier and Harriet Settlemier,

of 1650 North Pacific Highway, Albany County of Linn

State of Oregon, do hereby make application for a certificate of registration as evidence of a right to appropriate ground water.

1. **Source** from which water is withdrawn is Infiltration trench (abandoned borrow pit)
(Flowing well, pump well, infiltration trench, or tunnel)

2. **Location** is: Approximately one mile north of Albany, Oregon;
(Approximate distance and direction from nearest city or town)

and is more particularly described as follows: (See Note on Page 4)

(a) SW corner of tract is located from NW corner Milton Houston D.L.C. # 43 by bearing S 1° 56' E 1115.72'; thence S 89° 50' W, a distance of 934.73 feet.
(Give distance and bearing to corner of section or other legal subdivision)

Borrow pit is ~~being~~ within ~~East 2~~ NE¼ SW¼ of Sec. 33, Twp. 10S (N. or S.), Rge. 3W W.M. (E. or W.)
(Smallest legal subdivision)

or (b) within limits of recorded platted property, town or city:

in Lot ....., Block ..... of .....
(Name of plat or addition)

..... County of .....
(If within city or town, give name)

3. **Construction Work** was begun on 1948 (Date); was completed on 1948 (Date)

and the ground water claimed was first used for the purposes set out below on 1948 (Date),

since which time the water has been used Intermittently (Continuously or intermittently)

from 1948 (Date) to present (Date)

4. **Quantity** of water claimed and used is 100 gallons per minute; 10 acre feet per year.

5. **Purpose or Purposes** for which water is used for sprinkler irrigation of nursery stock
(Domestic, irrigation, municipal, manufacturing, industrial, etc.)

6. **Description of Well:** Depth ..... feet. Type ..... (Dug or drilled)

diameter ..... inches. Elevation of ground at well site 195 (As near as known) feet, mean sea level.

Depth to water table ..... feet.

7. **Capacity of Well:** ..... g.p.m. with ..... feet drawdown.

..... g.p.m. with ..... feet drawdown.

Date of test .....

If Flowing Well: Measured discharge ..... g.p.m. on ..... (Date)

Shut-in pressure at ground surface ..... lbs. per sq. in. on ..... (Date)

Water is controlled by ..... (Cap, valve, etc.)

8. **Casing:** (Give diameter, commercial specifications and depth below ground surface of each casing size.)

..... inch diameter ..... from ..... to ..... feet

..... inch diameter ..... from ..... to ..... feet

..... inch diameter ..... from ..... to ..... feet

..... inch diameter ..... from ..... to ..... feet

Describe and show depth of shoe, plug, adapter, liner or other details: .....

.....

.....

9. **Perforated Casings or Screens:**

..... from ..... to .....
(Number per foot and size of perforations, or describe screen)

..... from ..... to .....

..... from ..... to .....

..... from ..... to .....

10. **Log of Well:** (Describe each stratum or formation clearly, indicate if water bearing, and give thickness and depth as indicated.)

MATERIAL	Thickness (Feet)	Depth to Bottom (Feet)

If log of well is not available, give name and address of driller. .....

.....

11. **Infiltration Trench:** Covered or open open, abandoned borrow pit.

Dimensions: Length 125 x 200 ft. Minimum depth ~~300~~ 10 ft. Maximum depth 15 ft.

Bottom width 100 ft. Discharge ..... g.p.m. Date of test .....

12. **Tunnel:** Type of lining .....

Dimensions: .....
(Length, course, and cross sectional size)

Position of water bearing stratum with reference to portal of tunnel .....

.....

Log of tunnel: (Preceding table for log of well may be used, if desired. Give footage from portal and character of materials, as pertinent.)

13. **Pumping Equipment:**

(a) Pump Fairbanks-Morse, vertical centrifugal (Make, type and size) Capacity 100 approx. g.p.m.

(b) Motor Fairbanks-Morse, 5 horsepower, electric induction. (Type and horsepower)

14. Location of area irrigated or to be irrigated, or place of use if for purposes other than irrigation.

Township North or South	Range E. or W. of Willamette Meridian	Section	Forty-acre Tract	Number Acres To Be Irrigated	Date of Reclamation
10S	3W	33	NW¼ SE¼	~~8~~ 4½	1952
"	"	"	SW¼ NE¼	½	
				5 Ac.	1952

15. If the ground water supply is supplemental to an existing water supply, identification of any application for a permit, permit, certificate or adjudicated right to appropriate water made or held by the registrant.

.....

.....

GR 385 B

Township 10S Range 3W, W.M.

North

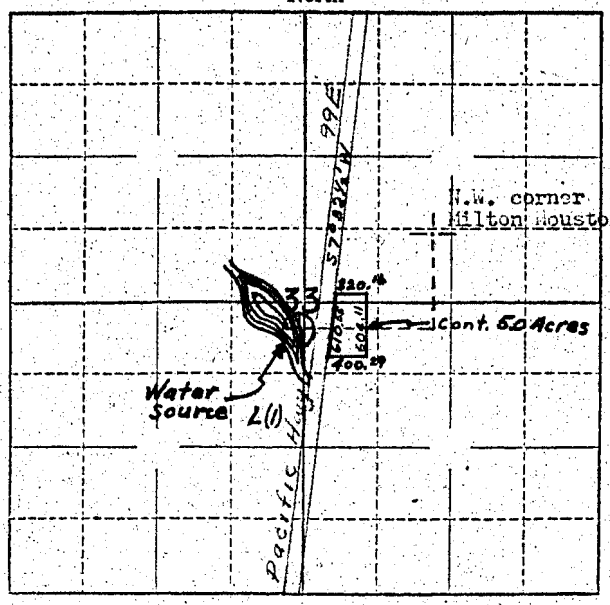

NOTE: Water source is located at a point which is referenced to NW corner D.L.C. #43 as follows: Bearing S 1° 56' E 900' from said corner; thence S 89° 50' W 1185.0' to approximate location of pump.

Locate well and acreage of irrigated land on plat.

Scale: ~~2"~~ 4" = 1 Mile

STATE OF OREGON
County of MARION } ss.

I, GEORGE & HARRIET SETTLEMIER, being first duly sworn, do hereby certify that I have read the foregoing Registration Statement and that all of the items therein contained are true to the best of my knowledge and belief.

George Settlemier
Harriet Settlemier
(Signature of Registrant)

Subscribed and sworn to before me this 15 day of MARCH, 1957

My commission expires JULY 24, 1960 Marvin W. Dale
(Notary Public)

(SEAL)

CERTIFICATE OF REGISTRATION

STATE OF OREGON
County of Marion } ss.

This is to certify that the foregoing Registration Statement was received in the office of the State Engineer on the 19th day of March, 19 57, at 8:00 o'clock A.M. and has been duly recorded in said office in Book No. 3 of Registration Statements on page GR-385 C

~~Construction shall be completed by x-x-x-x-x-x-x-x-x-x-x-19-x-x and the water completely applied to x beneficial use by x-x-x-x-x-x-x-x-x-x-19-x-x-~~ xx

Witness my hand this 23rd day of May 19 57

Lewis A. Stanley
(State Engineer)

$15.00

By
(Deputy)

GR - 385 C