

# Registration Statement

## OF CLAIMANT OF RIGHT TO APPROPRIATE GROUND WATER

TO THE STATE ENGINEER OF OREGON:

I, Lillie Hayes Mc Kay  
of 545 Colony Road County of Lane  
(Mailing address)

State of \_\_\_\_\_, do hereby make application for a certificate of registration as evidence of a right to appropriate ground water.

1. Source from which water is withdrawn is Two Driven Wells  
(Flowing well, pump well, infiltration trench, or tunnel)
2. Location is: 1/2 Mile East of Eugene, Oregon  
(Approximate distance and direction from nearest city or town)

and is more particularly described as follows:

(a) S. 56° 00' E. 573 ft. from S.E. Cor. C.W. Young D.L.E. 53  
(Give distance and bearing to corner of section or other legal subdivision)  
being within NW 1/4 NE 1/4 of Sec. 23, Twp. 17 S., Rge. 3 W.  
(Smallest legal subdivision) (Mer S.) (Mer W.)

or (b) within limits of recorded platted property, town or city: \_\_\_\_\_

in Lot \_\_\_\_\_ Block \_\_\_\_\_ of \_\_\_\_\_  
(Name of plat or addition)  
County of Lane  
(If within city or town, give name)

3. Construction Work was begun on March 1; was completed on June 1 - 1940  
(Date) (Date)

and the ground water claimed was first used for the purposes set out below on June 1 - 1940  
(Date)

since which time the water has been used Each Irrigation Season  
(Continuously or intermittently)

from May to October  
(Date) (Date)

4. Quantity of water claimed and used is 100 gallons per minute; \_\_\_\_\_ acre feet per year.

5. Purpose or Purposes for which water is used Irrigation of Pasture and Garden Crops  
(Domestic, irrigation, municipal, manufacturing, industrial, etc.)

6. Description of Well: Depth 28 feet. Type 2" Driven Pipe  
(Dug or drilled)  
diameter 2" inches. Elevation of ground at well site 429 feet, mean sea level.  
(As near as known)

Depth to water table 16 feet.

7. Capacity of Well: 100 g.p.m. with 20 feet drawdown.  
\_\_\_\_\_ g.p.m. with \_\_\_\_\_ feet drawdown.

Date of test May 1940

If Flowing Well: Measured discharge \_\_\_\_\_ g.p.m. on \_\_\_\_\_  
(Date)

Shut-in pressure at ground surface \_\_\_\_\_ lbs. per sq. in. on \_\_\_\_\_  
(Date)

Water is controlled by \_\_\_\_\_  
(Cap, valve, etc.)

8. Casing: (Give diameter, commercial specifications and depth below ground surface of each casing size.)

2" inch diameter ..... from 0 to 28 feet  
 ..... inch diameter ..... from ..... to ..... feet  
 ..... inch diameter ..... from ..... to ..... feet  
 ..... inch diameter ..... from ..... to ..... feet

Describe and show depth of shoe, plug, adapter, liner or other details: .....

.....

9. Perforated Casings or Screens:

Bottom 2' about 100 1/4" Holes ..... from 26' to 28'  
(Number per foot and size of perforations, or describe screen)  
 ..... from ..... to .....  
 ..... from ..... to .....  
 ..... from ..... to .....

10. Log of Well: (Describe each stratum or formation clearly, indicate if water bearing, and give thickness and depth as indicated.)

MATERIAL	Thickness (Feet)	Depth to Bottom (Feet)
1'-10' Sandy Loam	10'	10'
10'-23' Sand and Gravel	13'	23'
23'-28' Water bearing Gravel	5'	28'

If log of well is not available, give name and address of driller.

535 Coburn Road Eugene License no 91  
Mayer Haged

11. Infiltration Trench: Covered or open

Dimensions: Length ft. Minimum depth ft. Maximum depth ft.

Bottom width ft. Discharge g.p.m. Date of test

12. Tunnel: Type of lining

Dimensions: (Length, course, and cross sectional size)

Position of water bearing stratum with reference to portal of tunnel

Log of tunnel: (Preceding table for log of well may be used, if desired. Give footage from portal and character of materials, as pertinent.)

13. Pumping Equipment:

(a) Pump Fairbanks Morse 1 1/2 Capacity 100 g.p.m.  
(Make, type and size)


(b) Motor Fairbanks Single Phase 3-HP  
(Type and horsepower)

14. Location of area irrigated or to be irrigated, or place of use if for purposes other than irrigation.

Township or other South	Range East W. of Willamette Meridian	Section	Forty-acre Tract	Number Acres To Be Irrigated	Date of Reclamation
17 S.	3 W.	29	NE 1/4 NW 1/4	3 Ac.	1940
"	"	"	NW 1/4 NE 1/4	16 Ac	"
"	"	"	SE 1/4 NW 1/4	3 1/2 Ac.	"
"	"	"	SW 1/4 NE 1/4	7.2 Ac.	"
				<u>29.7 Ac</u>	

15. If the ground water supply is supplemental to an existing water supply, identification of any application for a permit, permit, certificate or adjudicated right to appropriate water made or held by the registrant.

Township 17 S, Range 3 W, W.M.  
North

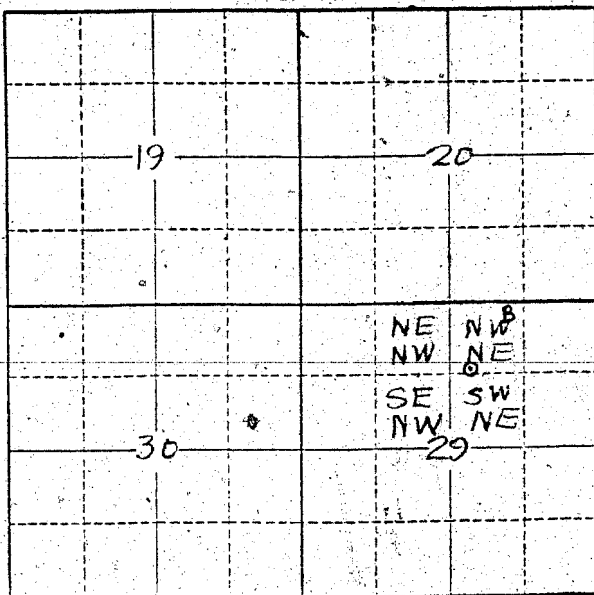

SEE LARGE MAP

Locate well and acreage of irrigated land on plat.  
Scale: 2" = 1 Mile

STATE OF OREGON

County of Lane } ss.

I, Lillie Hayes McKay, being first duly sworn, do hereby certify that I have read the foregoing Registration Statement and that all of the items therein contained are true to the best of my knowledge and belief.

Lillie Hayes McKay  
(Signature of Registrant)

Subscribed and sworn to before me this 1st day of August, 1958.

My commission expires CHARLES W. ROFFE  
My Commission Expires June 24, 1961

Charles W. Roffe  
(Notary Public)

(SEAL)

**CERTIFICATE OF REGISTRATION**

STATE OF OREGON

County of Marion } ss.

This is to certify that the foregoing Registration Statement was received in the office of the State Engineer on the 4th day of August, 1958, at 8.00 o'clock A.M. and has been duly recorded in said office in Book No. 15 of Registration Statements on page 58-3623

Witness my hand this 15th day of September, 19 59

Lewis A. Stanley  
(State Engineer)

15.00

By \_\_\_\_\_  
(Deputy)

GR 3623