

Registration Statement

OF CLAIMANT OF RIGHT TO APPROPRIATE GROUND WATER

TO THE STATE ENGINEER OF OREGON:

I, Joseph A. Holiday
of 365 Coburg Road (Mailing address) County of Lane

State of Oregon, do hereby make application for a certificate of registration as evidence of a right to appropriate ground water.

1. Source from which water is withdrawn is Dump well
(Flowing well, pump well, infiltration trench, or tunnel)

2. Location is: NE Eugene Oregon 1/2 mile on Coburg Road from Ferry Street Bridge
(Approximate distance and direction from nearest city or town)

and is more particularly described as follows:

(a) about 350 feet west and 600 feet south from NE corner of Section 29,
NE (Give distance and bearing to corner of section or other legal subdivision)
being within 1/4 of NE 1/4 of Sec. 29, Twp. 17S, Rge. R3W-21N
(Smallest legal subdivision) (N. or S.) (E. or W.)

or (b) within limits of recorded platted property, town or city: _____

in lot _____, Block _____ of _____
(Name of plat or addition)
County of _____
(If within city or town, give name)

3. Construction Work was begun on June 1950; was completed on 3 days later
(Date) (Date)
and the ground water claimed was first used for the purposes set out below on June 1950
(Date)

since which time the water has been used continuously
(Continuously or intermittently)
from June 1950 to August 1958
(Date) (Date)

4. Quantity of water claimed and used is 125 gallons per minute; _____ acre feet per year.

5. Purpose or Purposes for which water is used (exempt) irrigation
(Domestic, irrigation, municipal, manufacturing, industrial, etc.)

6. Description of Well: Depth 26 feet. Type drilled
(Dug or drilled)
diameter 5 inches. Elevation of ground at well site Same as 10920 feet, mean sea level.
(As near as known)
Depth to water table 14 feet.

7. Capacity of Well: 125 g.p.m. with unknown feet drawdown.
_____ g.p.m. with _____ feet drawdown.

Date of test June 1950

If Flowing Well: Measured discharge _____ g.p.m. on _____ (Date)

Shut-in pressure at ground surface _____ lbs. per sq. in. on _____ (Date)

Water is controlled by _____ (Cap, valve, etc.)

8. Casing: (Give diameter, commercial specifications and depth below ground surface of each casing size.)

5 inch diameter *steel pipe galvanized* from to feet
 inch diameter from to feet
 inch diameter from to feet
 inch diameter from to feet

Describe and show depth of shoe, plug, adapter, liner or other details: *3" galvanized pipe with foot valve*

9. Perforated Casings or Screens:

centron from to
(Number per foot and size of perforations, or describe screen)
 from to
 from to
 from to

10. Log of Well: (Describe each stratum or formation clearly, indicate if water bearing, and give thickness and depth as indicated.)

MATERIAL	Thickness (Feet)	Depth to Bottom (Feet)

If log of well is not available, give name and address of driller. Dell Page
Hoursburg Oregon

11. Infiltration Trench: Covered or open none
 Dimensions: Length ft. Minimum depth ft. Maximum depth ft.
 Bottom width ft. Discharge g.p.m. Date of test
12. Tunnel: Type of lining none
 Dimensions:
 (Length, course, and cross sectional size)
 Position of water bearing stratum with reference to portal of tunnel

Log of tunnel: (Preceding table for log of well may be used, if desired. Give footage from portal and character of materials, as pertinent.)

13. Pumping Equipment: centrifugal
 (a) Pump Bertley electric drive Capacity unknown g.p.m.
(Make, type and size)
 (b) Motor 5 horsepower Westinghouse
(Type and horsepower)


14. Location of area irrigated or to be irrigated, or place of use if for purposes other than irrigation.

Township North or South	Range E. or W. of Willamette Meridian	Section	Forty-acre Tract	Number Acres To Be Irrigated	Date of Reclamation
17S	3 West	29	N ^E 1/4 of the NE 1/4	5 acres	1950

15. If the ground water supply is supplemental to an existing water supply, identification of any application for a permit, permit, certificate or adjudicated right to appropriate water made or held by the registrant.

See attached diagram.

Township 17S Range 32W, W.M.
North

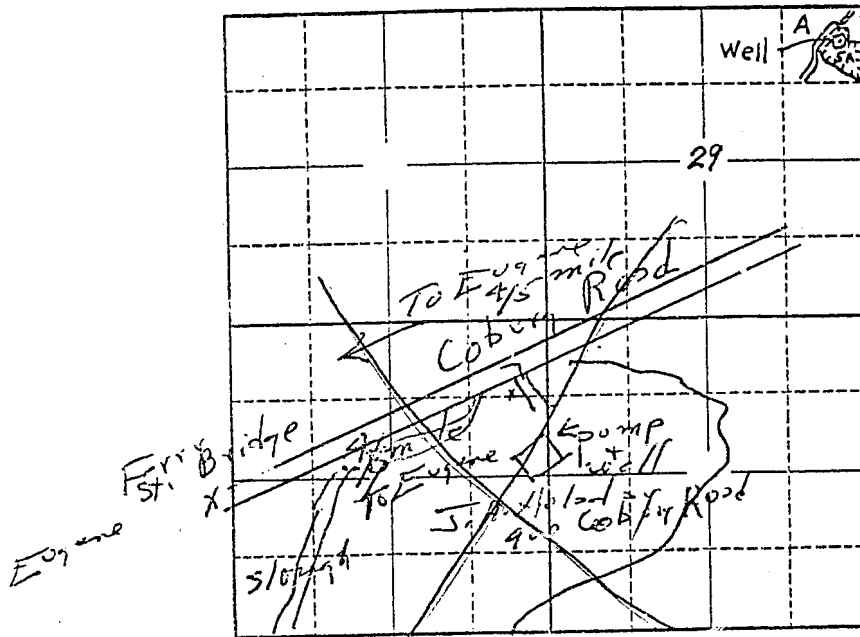

Locate well and acreage of irrigated land on plat.
Scale: 2" = 1 Mile

STATE OF OREGON

County of Lane } ss.

I, Joseph A. Holdaway, being first duly sworn, do hereby certify that I have read the foregoing Registration Statement and that all of the items therein contained are true to the best of my knowledge and belief.

Joseph A. Holdaway
(Signature of Registrant)

Subscribed and sworn to before me this 1 day of August, 1958

My commission expires _____
(SEAL) My Commission Expires July 27, 1960

[Signature]
(Notary Public)

CERTIFICATE OF REGISTRATION

STATE OF OREGON } ss.
County of Marion

This is to certify that the foregoing Registration Statement was received in the office of the State Engineer on the 4th day of August, 1958, at 2:00 o'clock A.M. and has been duly recorded in said office in Book No. 17 of Registration Statements on page GR-4142

Witness my hand this 5th day of August, 1966

[Signature]
(State Engineer)

15.00

By _____
(Deputy)

GR 4142