

Registration Statement

OF CLAIMANT OF RIGHT TO APPROPRIATE GROUND WATER

TO THE STATE ENGINEER OF OREGON:

I, Kathryn E. Wise and John G. Kilburn
of 311 River Avenue Eugene, Oregon (Mailing address) County of Lane

State of Oregon, do hereby make application for a certificate of registration as evidence of a right to appropriate ground water.

1. Source from which water is withdrawn is Pump Well Lettered B. on Map
(Flowing well, pump well, infiltration trench, or tunnel)

2. Location is: App. 3 miles North of Eugene
(Approximate distance and direction from nearest city or town)

and is more particularly described as follows: 543.75 North of S.E. Corner of Lot D County Survey #686 & thence west 8ft to well
(a) 850 feet West & 640 feet South from N.W. corner Section 13
(Give distance and bearing to corner of section or other legal subdivision)

being within NE 1/4 of NW 1/4 of Sec. 13 Twp. 17 S Rge. 4 W
(Smallest legal subdivision) (or S.) (or W.)

or (b) within limits of recorded platted property, town or city: Lane County Survey #686

in Lot D, Block - of Potters Survey
(Name of plat or addition)

County of Lane
(If within city or town, give name)

3. Construction Work was begun on May, 1943, was completed on May 1943
(Date) (Date)

and the ground water claimed was first used for the purposes set out below on May 1943
(Date)

since which time the water has been used Continuously
(Continuously or intermittently)

from May 1943 to Present
(Date) (Date)

4. Quantity of water claimed and used is 120 gallons per minute; 20 acre feet per year.

5. Purpose or Purposes for which water is used Irrigation
(Domestic, irrigation, municipal, manufacturing, industrial, etc.)

6. Description of Well: Depth 24 feet. Type driven
(Dug or drilled)

diameter 2-2 1/2" M=2 folded inches. Elevation of ground at well site 350 feet, mean sea level.
(As near as known)

Depth to water table 12 feet.


7. Capacity of Well: - g.p.m. with - feet drawdown.
- g.p.m. with - feet drawdown.

Date of test No test

If Flowing Well: Measured discharge - g.p.m. on - (Date)

Shut-in pressure at ground surface - lbs. per sq. in. on - (Date)

Water is controlled by -
(Cap, valve, etc.)

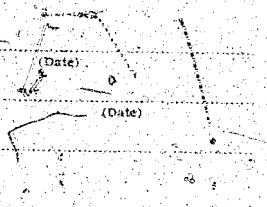

8. Casing: (Give diameter, commercial specifications and depth below ground surface of each casing size.)

2 - 2 1/2" inch diameter from 0 to 24 feet
..... inch diameter from to feet
..... inch diameter from to feet
..... inch diameter from to feet

Describe and show depth of shoe, plug, adapter, liner or other details: _____

9. Perforated Casings or Screens:

2 - 2 1/2 inch Manifold, slotted, pointed from 20 to 24
(Number per foot and size of perforations, or describe screen)
..... from to
..... from to
..... from to

10. Log of Well: (Describe each stratum or formation clearly, indicate if water bearing, and give thickness and depth as indicated.)

MATERIAL	Thickness (Feet)	Depth to Bottom (Feet)

If log of well is not available, give name and address of driller.

11. Infiltration Trench: Covered or open

Dimensions: Length ft. Minimum depth ft. Maximum depth ft.

Bottom width ft. Discharge g.p.m. Date of test

12. Tunnel: Type of lining

Dimensions:
(Length, course, and cross sectional size)

Position of water bearing stratum with reference to portal of tunnel

Log of tunnel: (Preceding table for log of well may be used, if desired. Give footage from portal and character of materials, as pertinent.)

13. Pumping Equipment:

(a) Pump 2" x 1 1/2" Close Coupled Capacity 120 g.p.m.
(Make, type and size)

(b) Motor 5 HP 3 phase
(Type and horsepower)

14. Location of area irrigated or to be irrigated, or place of use if for purposes other than irrigation.


Township North of South	Range E. or W. of Willamette Meridian	Section	Forty-acre Tract	Number Acres To Be Irrigated	Date of Reclamation
175	4W	Lot D.	NE 1/4 of NW 1/4 County Survey # 686 Patters Survey # 686	8 ⁰	May 1943

15. If the ground water supply is supplemental to an existing water supply, identification of any application for a permit, permit, certificate or adjudicated right to appropriate water made or held by the registrant.

Township 17S Range 4W W.M.

North

This well

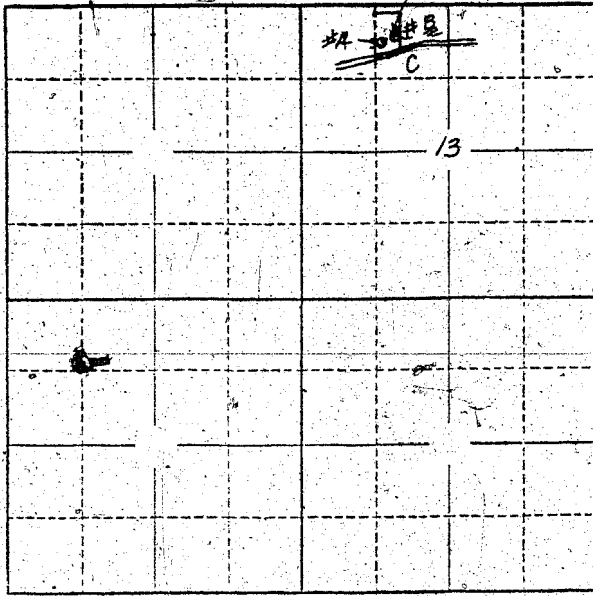

Locate well and acreage of irrigated land on plat.

Scale: 2" = 1 Mile

STATE OF OREGON

County of Lane

I, John De Wilton, being first duly sworn, do hereby certify that I have read the foregoing Registration Statement and that all of the items therein contained are true to the best of my knowledge and belief.

John De Wilton
(Signature of Registrant)

Subscribed and sworn to before me this 1 day of August 1958.

My commission expires Sept 28 1958

[Signature]
(Notary Public)

(SEAL)

CERTIFICATE OF REGISTRATION

STATE OF OREGON

County of Marion

This is to certify that the foregoing Registration Statement was received in the office of the State Engineer on the 4th day of August, 1958, at 2:00 o'clock A. M. and has been duly recorded in said office in Book No. 15 of Registration Statements on page 3624

Witness my hand this 15th day of September, 1959

Lewis A. Stanley
(State Engineer)

By _____ (Deputy)

\$15.00