

# Registration Statement

## OF CLAIMANT OF RIGHT TO APPROPRIATE GROUND WATER

TO THE STATE ENGINEER OF OREGON:

I, Lyle N. Miller & Miss Jane Miller  
of 7630 S.W. 195<sup>th</sup> Avenue, Beaverton, Ore County of Washington  
State of Oregon, do hereby make application for a certificate of registration as evidence  
of a right to appropriate ground water.

1. Source from which water is withdrawn is Kearney Hill Spring  
(Flowing well, pump well, infiltration trench, or tunnel)

2. Location is: 2 miles to Clatskanie, Ore.  
(Approximate distance and direction from nearest city or town)

and is more particularly described as follows: 800 feet North & 150 feet east from S 1/4 corner Section 24

(a) Property is Dead End of 195<sup>th</sup> South of Farmington Rd.  
(Give distance and bearing to corner of section or other legal subdivision)

(Smallest legal subdivision) (N. or S.) (E. or W.)

or (b) within limits of recorded platted property, town or city  
Cooper Mt. 4 Sec. 24 in the County of Washington, State of Oregon

in Lot \_\_\_\_\_, Block \_\_\_\_\_ of \_\_\_\_\_  
(Name of plat or addition)

County of \_\_\_\_\_  
(If within city or town, give name)

3. Construction Work was begun on May 4, 1951; was completed on June 5, 1951  
(Date) (Date)

and the ground water claimed was first used for the purposes set out below on Spring 1951 Well, 1951  
(Date)

since which time the water has been used Continuously  
(Continuously or intermittently)

from 1898 to 1958  
(Date) (Date)

4. Quantity of water claimed and used is 12 g.p.m. from well gallons per minute; \_\_\_\_\_ acre  
feet per year.

5. Purpose or Purposes for which water is used Domestic & Irrigation  
(Domestic, irrigation, municipal, manufacturing, industrial, etc.)

Spring was for stock I could use a natural tank for  
if it was made into a well and for part of irrigation  
6. Description of Well: Depth 24 feet. Type drilled well  
(Dug or drilled)

diameter 6" inches. Elevation of ground at well site 460 feet, mean sea level.  
(As near as known)

Depth to water table 230 feet.

7. Capacity of Well: 12 g.p.m. with more feet drawdown.  
\_\_\_\_\_ g.p.m. with \_\_\_\_\_ feet drawdown.

Date of test June 5, 1951

If Flowing Well: Measured discharge \_\_\_\_\_ g.p.m. on \_\_\_\_\_  
(Date)

Shut-in pressure at ground surface \_\_\_\_\_ lbs. per sq. in. on \_\_\_\_\_  
(Date)

Water is controlled by \_\_\_\_\_  
(Cap, valve, etc.)

8. Casing: (Give diameter, commercial specifications and depth below ground surface of each casing size.)

Cased 6" <sup>Standard Eastern</sup> inch diameter <sup>with 1/2 collar.</sup> 21 ft from ground to rock feet

6" inch diameter Cemented then drilled from 104' to 127 feet

6" inch diameter thru solid rock from 127' to 241 feet

inch diameter from to feet

Describe and show depth of shoe, plug, adapter, liner or other details:

.....

.....

9. Perforated Casings or Screens:

..... from to

(Number per foot and size of perforations, or describe screen)

..... from to

..... from to

..... from to

10. Log of Well: (Describe each stratum or formation clearly, indicate if water bearing, and give thickness and depth as indicated.)

MATERIAL	Thickness (Feet)	Depth to Bottom (Feet)
6" Standard Eastern with 1/2" collar	21'	241'


11. Infiltration Trench: Covered or open \_\_\_\_\_  
 Dimensions: Length \_\_\_\_\_ ft. Minimum depth \_\_\_\_\_ ft. Maximum depth \_\_\_\_\_ ft.  
 Bottom width \_\_\_\_\_ ft. Discharge \_\_\_\_\_ g.p.m. Date of test \_\_\_\_\_

12. Tunnel: Type of lining \_\_\_\_\_  
 Dimensions: \_\_\_\_\_  
 (Length, course, and cross sectional size)  
 Position of water bearing stratum with reference to portal of tunnel \_\_\_\_\_

Log of tunnel: (Preceding table for log of well may be used, if desired. Give footage from portal and character of materials, as pertinent.)

13. Pumping Equipment:  
 (a) Pump Meyer Pump 204716 Serial Number 12 Capacity 8 g.p.m.  
 (b) Motor B. H. P. C. L. T. (Type and horsepower)


14. Location of area irrigated or to be irrigated, or place of use if for purposes other than irrigation.

Township North or South	Range E. or W. of Willamette Meridian	Section	Forty-acre Tract	Number Acres To Be Irrigated	Date of Reclamation
<u>1 South</u>	<u>2 W W M</u>	<u>SW 1/4 of Sec 24</u>	<u>NO RECORD</u>	<u>about 25</u>	
<u>TIS</u>	<u>R 2 W</u>	<u>24</u>	<u>SW 1/4 of SE 1/4</u>	<u>25.2</u>	<u>1951</u>

15. If the ground water supply is supplemental to an existing water supply, identification of any application for a permit, permit, certificate or adjudicated right to appropriate water made or held by the registrant.

with no permit or certificate of water appropriation  
and no permit for any natural dam or  
used to supplement irrigation & stock supply

S.W. 1/4 of S.E. 1/4 Sec. 24 Township 1 South Range 2 W.W.M., W.M.  
North

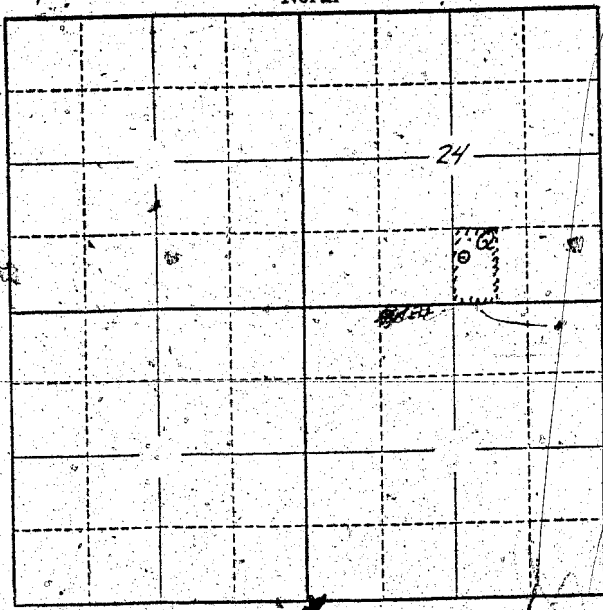

Locate well and acreage of irrigated land on plat.  
Scale: 2" = 1 Mile

STATE OF OREGON }  
County of Umatilla } ss.

We, I Lyle R. Miller & Jane Miller, being first duly sworn, do hereby certify that I have read the foregoing Registration Statement and that all of the items therein contained are true to the best of my knowledge and belief.

*Jane Miller Lyle R. Miller*  
(Signature of Registrant)

Subscribed and sworn to before me this 2nd day of August, 1958

My commission expires February 20, 1959  
(Notary Public)

(SEAL)

CERTIFICATE OF REGISTRATION

STATE OF OREGON }  
County of Marion } ss.

This is to certify that the foregoing Registration Statement was received in the office of the State Engineer on the 4 day of August, 1958, at 8:00 o'clock A.M. and has been duly recorded in said office in Book No. 15 of Registration Statements on page 3627

Witness my hand this 15th day of September, 1959  
*Lewis A. Stanley*  
(State Engineer)

\$15.00

By \_\_\_\_\_  
(Deputy)

GR 3627