

RECEIVED

AUG. 1, 1958

STATE ENGINEER
SALEM, OREGON

Registration No. GR-4036

Certificate No. GR-3774

Registration Statement

OF CLAIMANT OF RIGHT TO APPROPRIATE GROUND WATER

TO THE STATE ENGINEER OF OREGON:

RIVERSIDE GOLF & COUNTRY CLUB

I, _____

of 8105 N. E. Sunderland Rd Portland County of Multnomah

(Mailing address)

State of Oregon, do hereby make application for a certificate of registration as evidence of a right to appropriate ground water.

1. Source from which water is withdrawn is PUMP WELL
(Flowing well, pump well, infiltration trench, or tunnel)

2. Location is: ONE MILE
(Approximate distance and direction from nearest city or town)

and is more particularly described as follows: SEE ATTACHED:

(a) 300 feet south & 200 feet east from W 1/4 corner Section 12
NW 1/4 of SW 1/4 (Give distance and bearing to corner of section or other legal subdivision)

being within SUNDERLAND ACRES of Sec. 12, Twp. 1 North, Rge. 1 East
(Smallest legal subdivision) (N. or S.) (E. or W.)

or (b) within limits of recorded platted property, town or city: _____

in Lot _____, Block _____ of _____
(Name of plat or addition)

County of Multnomah
(If within city or town, give name)

3. Construction Work was begun on December 1st 1945, was completed on March 1st 1946
(Date) (Date)

and the ground water claimed was first used for the purposes set out below on April 1946
(Date)

since which time the water has been used INTERMITTENTLY
(Continuously or intermittently)

from MARCH to SEPTEMBER
(Date) (Date)

4. Quantity of water claimed and used is 900 gallons per minute; _____ acre feet per year.

5. Purpose or Purposes for which water is used SPRINKLING SYSTEM GOLF COURSE
IRRIGATION
(Domestic, irrigation, municipal, manufacturing, industrial, etc.)

6. Description of Well: Depth 145 feet. Type Drilled
(Dug or drilled)

diameter 14 inches. Elevation of ground at well site 50 feet, mean sea level.
(As near as known)

Depth to water table 3 feet.

7. Capacity of Well: 900 g.p.m. with 132 feet drawdown.

_____ g.p.m. with _____ feet drawdown.

Date of test March 1st 1946

If Flowing Well: Measured discharge _____ g.p.m. on _____
(Date)

Shut-in pressure at ground surface _____ lbs. per sq. in. on _____
(Date)

Water is controlled by _____
(Cap, valve, etc.)

8. Casing: (Give diameter, commercial specifications and depth below ground surface of each casing size.)

8 inch diameter from to 125 feet
 8 inch diameter from to 10 feet
 inch diameter from to feet
 inch diameter from to feet

Describe and show depth of shoe, plug, adapter, liner or other details:

9. Perforated Casings or Screens:

..... from 125' to 142'
 (Number per foot and size of perforations, or describe screen)
 from to
 from to
 from to

10. Log of Well: (Describe each stratum or formation clearly, indicate if water bearing, and give thickness and depth as indicated.)

MATERIAL	Thickness (Feet)	Depth to Bottom (Feet)
SURFACE TO 6 FEET TOP SOIL		
6 FEET TO 31 FEET SAND		
31 FEET TO 70 feet Blue & Brown Clay		
70 FEET to 77 feet Sand		
77 FEET to 91 feet Brown silt & Sand		
91 Feet to 94 feet Sand		
94 Feet to 98 feet Sand with small gravel		
98 feet to 119 feet Sand		
119 Feet to 141 Feet Gravel & Sand with some clay binder, Water		
141 to 149 ft Cemented Gravel		
CASED TO 145 Feet with 14 inch O.D 3/8 inch wall New Pipe		
Back filled to 145 feet.		
perforated from 125 to 142 feet.		
Static water level 3 feet from surface		
Pump test 500 Gpm draw down 98 ft		
pump test 600 " " " 108 ft		
pump test 700 " " " 117 ft		
Pump test 800 " " " 125 ft		
Pump test 900 " GR " " 132 ft		

If log of well is not available, give name and address of driller: R. J. STRASSER

DRILLING COMPANY PORTLAND

11. Infiltration Trench: Covered or open
Dimensions: Length ft. Minimum depth ft. Maximum depth ft.
Bottom width ft. Discharge g.p.m. Date of test

12. Tunnel: Type of lining
Dimensions:
(Length, course, and cross sectional size)
Position of water bearing stratum with reference to portal of tunnel

Log of tunnel: (Preceding table for log of well may be used, if desired. Give footage from portal and character of materials, as pertinent.)

13. Pumping Equipment:
(a) Pump 1750 RPM 100 HP Peerless Capacity 900 g.p.m.
(Make, type and size)
(b) Motor Gen Elec. (Type and horsepower)


14. Location of area irrigated or to be irrigated, or place of use if for purposes other than irrigation.

Township North or South	Range E. or W. of Willamette Meridian	Section	Forty-acre Tract	Number Acres To Be Irrigated	Date of Reclamation
T1N	R1E	11	SW ¹ / ₄ of NE ¹ / ₄	APPROX 100 40 [±]	1946
"	"	"	SE ¹ / ₄ of NE ¹ / ₄	40 [±]	"
"	"	12	SW ¹ / ₄ of NW ¹ / ₄	12 [±]	"
"	"	12	NW ¹ / ₄ of SW ¹ / ₄	28 [±]	"
			Total	100 [±]	"

15. If the ground water supply is supplemental to an existing water supply, identification of any application for a permit, permit, certificate or adjudicated right to appropriate water made or held by the registrant.

Township 1N Range 1E W.M.

North

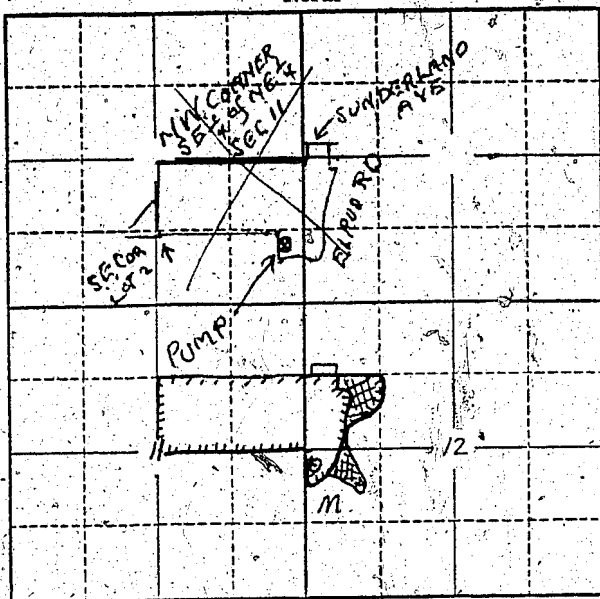

Locate well and acreage of irrigated land on plat.

Scale: 2" = 1 Mile

STATE OF OREGON

County of Multnomah } ss.

I, William B. Graham, being first duly sworn, do hereby certify that I have read the foregoing Registration Statement and that all of the items therein contained are true to the best of my knowledge and belief.

William B. Graham
(Signature of Registrant)

Subscribed and sworn to before me this 17th day of August, 1958

My commission expires 1-7-62

Angene (P. ...)
(Notary Public)

(SEAL)

CERTIFICATE OF REGISTRATION

STATE OF OREGON

County of Marion } ss.

This is to certify that the foregoing Registration Statement was received in the office of the State Engineer on the 4 day of August, 1958, at 8.00 o'clock A.M. and has been duly recorded in said office in Book No. 16 of Registration Statements on page GR-3774

Witness my hand this 20th day of October, 1959

Lewis A. Stanley
(State Engineer)

By _____

(Deputy)

GR 3774

\$ 25.50