

Registration Statement

OF CLAIMANT OF RIGHT TO APPROPRIATE GROUND WATER

TO THE STATE ENGINEER OF OREGON:

I, G. F. Brood
of 1422 Gebhard Road, Central Point, County of Jackson
(Mailing address)
State of Oregon, do hereby make application for a certificate of registration as evidence of a right to appropriate ground water.

1. Source from which water is withdrawn is Pump Well
(Flowing well, pump well, infiltration trench, or tunnel)

2. Location is: one mile northeast of Central Point, Oregon
(Approximate distance and direction from nearest city or town)

and is more particularly described as follows:

(a) 33 Rods West from NE corner of Sec 142 about 10 Rods South
(Give distance and bearing to corner of section or other legal subdivision)

being within NE¹ NE² of Sec. 1, Twp. 37 S., Rge. 2 W.
(Smallest legal subdivision) (S. or N.) (E. or W.)

or (b) within limits of recorded platted property, town or city:

in Lot _____, Block _____ of _____
(Name of plat or addition)

County of _____
(If within city or town, give name)

3. Construction Work was begun on 1946; was completed on 1946
(Date) (Date)

and the ground water claimed was first used for the purposes set out below on 1946
(Date)

since which time the water has been used continuously
(Continuously or intermittently)

from 1946 to present
(Date) (Date)

4. Quantity of water claimed and used is 50 gallons per minute; 35.1 acre plus stock use.
feet per year.

5. Purpose or Purposes for which water is used irrigation and stock purposes

(Domestic, irrigation, municipal, manufacturing, industrial, etc.)

6. Description of Well: Depth 20 feet. Type Dug
(Dug or drilled)

diameter 6 feet inches. Elevation of ground at well site 1248 feet, mean sea level.
(As near as known)

Depth to water table 14 feet at present.

7. Capacity of Well: unknown g.p.m. with _____ feet drawdown.

_____ g.p.m. with _____ feet drawdown.

Date of test not any test made.

If Flowing Well: Measured discharge _____ g.p.m. on _____
(Date)

Shut-in pressure at ground surface _____ lbs. per sq. in. on _____
(Date)

Water is controlled by _____
(Cap, valve, etc.)

8. Casing: (Give diameter, commercial specifications and depth below ground surface of each casing size.)

6 ft. inch diameter on top is cement blocks, then from top to feet
 inch diameter plastered for a ways from to feet
 inch diameter then a metal casing on bottom from to 20 feet
 inch diameter from to feet

Describe and show depth of shoe, plug, adapter, liner or other details: above described.

9. Perforated Casings or Screens:

none from to
(Number per foot and size of perforations, or describe screen)
 from to
 from to
 from to

10. Log of Well: (Describe each stratum or formation clearly, indicate if water bearing, and give thickness and depth as indicated.)

MATERIAL	Thickness (Feet)	Depth to Bottom (Feet)
yellow	10	10
gravel (water bearing)	10	0

If log of well is not available, give name and address of driller. unknown

11. Infiltration Trench: Covered or open

Dimensions: Length ft. Minimum depth ft. Maximum depth ft.

Bottom width ft. Discharge g.p.m. Date of test

12. Tunnel: Type of lining

Dimensions:
(Length, course, and cross sectional size)

Position of water bearing stratum with reference to portal of tunnel

Log of tunnel: (Preceding table for log of well may be used, if desired. Give footage from portal and character of materials, as pertinent)

13. Pumping Equipment:

(a) Pump $1\frac{1}{2}$ " intake and $1\frac{1}{4}$ " outlet at pump. Capacity $(50\frac{gpm}{3000})$ gallons per hour / 3000 g.p.m.
(Make, type and size)


(b) Motor 3 H.P. electric motor
(Type and horsepower)

14. Location of area irrigated or to be irrigated, or place of use if for purposes other than irrigation.

Township North or South	Range E. or W. of Willamette Meridian	Section	Forty-acre Tract	Number Acres To Be Irrigated	Date of Reclamation
T. 37 S.	2 W.	1	NE ¹ NE ¹	7.8	1946

15. If the ground water supply is supplemental to an existing water supply, identification of any application for a permit, permit, certificate or adjudicated right to appropriate water made or held by the registrant.
..... none

Township 37S Range 2W, W.M.
North

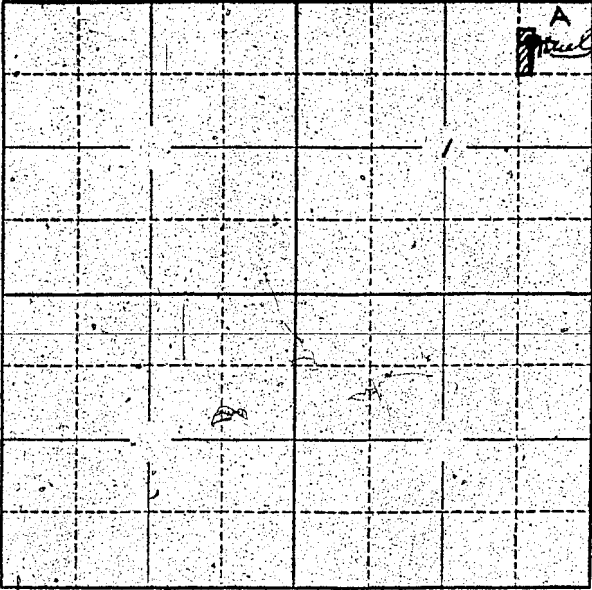

Locate well and acreage of irrigated land on plat.
Scale: 2" = 1 Mile

STATE OF OREGON

County of Jackson } ss.

I, G. F. Brood being first duly sworn, do hereby certify that I have read the foregoing Registration Statement and that all of the items therein contained are true to the best of my knowledge and belief.

G. F. Brood
(Signature of Registrant)

Subscribed and sworn to before me this 1st day of August, 1958

My commission expires August 25, 1958

Alfred R. Kuntz
(Notary Public)

(SEAL)

CERTIFICATE OF REGISTRATION

STATE OF OREGON

County of Marion } ss.

This is to certify that the foregoing Registration Statement was received in the office of the State Engineer on the 4 day of August, 1958, at 8:00 o'clock A.M. and has been duly recorded in said office in Book No. 15 of Registration Statements on page GR-3639

Witness my hand this 15th day of September, 1959

Alfred A. Stanley
(State Engineer)

\$15.00

By _____ (Deputy)

GR 3639