

Registration Statement

OF CLAIMANT OF RIGHT TO APPROPRIATE GROUND WATER

(Under Chapter 708, Oregon Laws 1955.)

TO THE STATE ENGINEER OF OREGON:

I, Nell H. Turridge
of RED E Jefferson County of Maxim
State of Oregon, do hereby make application for a certificate of registration as evidence of a right to appropriate ground water.

- 1. Source from which water is withdrawn is pump well - industrial
(Flowing well, pump well, infiltration trench, or tunnel)
- 2. Location is: 3 mi. W of Jefferson Oregon
(Approximate distance and direction from nearest city or town)

and is more particularly described as follows:

- (a) 580' north + 1540' W of SE corner of Sec. 34
(Give distance and bearing to corner of section or other legal subdivision)
- being within SW quarter SE quarter of Sec. 34, Twp. 9S, Rge. 3W
(Smallest legal subdivision) (S. or S.) (E. or W.)
- or (b) within limits of recorded platted property, town or city: _____

in Lot _____ Block _____ of _____
(Name of plat or addition)
County of _____
(If within city or town, give name)

3. Construction Work was begun on 1945; was completed on 1945
(Date) (Date)

and the ground water claimed was first used for the purposes set out below on 1945
(Date)

since which time the water has been used continuously
(Continuously or intermittently)
from 1945 to date
(Date) (Date)

4. Quantity of water claimed and used is 6.0 gallons per minute; 1.0 acre feet per year.

5. Purpose or Purposes for which water is used domestic + peppermint distillery
(Domestic, irrigation, municipal, manufacturing, industrial, etc.)

6. Description of Well: Depth 40 feet. Type drilled
(Dug or drilled)
diameter 8 inches. Elevation of ground at well site 725 feet, mean sea level.
(As near as known)
Depth to water table 16 feet.

7. Capacity of Well: _____ g.p.m. with _____ feet drawdown.
_____ g.p.m. with _____ feet drawdown.


Date of test _____

If Flowing Well: Measured discharge _____ g.p.m. on _____
(Date)

Shut-in pressure at ground surface _____ lbs. per sq. in. on _____
(Date)

Water is controlled by _____
(Cap, valve, etc.)

Township 95 Range 34, W.M.
103 North

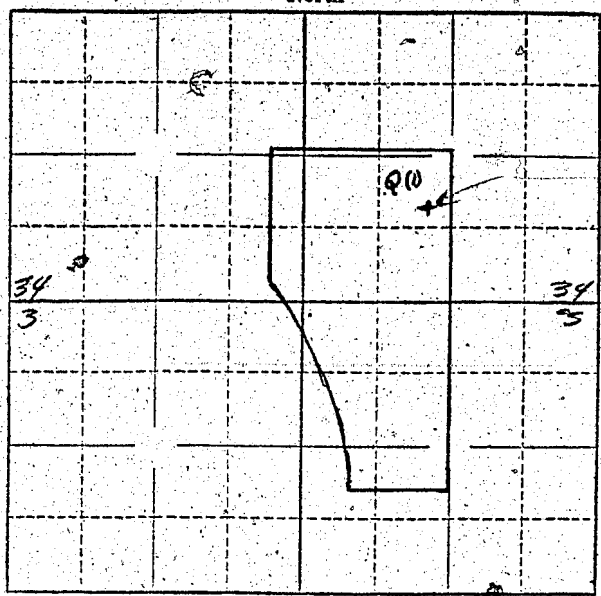

Locate well and acreage of irrigated land on plat.
 Scale: 1" = 1 Mile

STATE OF OREGON

County of _____ } ss.

I, _____, being first duly sworn, do hereby certify that I have read the foregoing Registration Statement and that all of the items therein contained are true to the best of my knowledge and belief.

 (Signature of Registrant)

Subscribed and sworn to before me this _____ day of _____, 19_____.

My commission expires _____
 (Notary Public)

(SEAL)

See Page GR-387 W for
CERTIFICATE OF REGISTRATION

STATE OF OREGON

County of Marion } ss.

~~This is to certify that the foregoing Registration Statement was received in the office of the State Engineer on the X-X-X day of X-X-X-X-X-X-X-X, 19X-X, at X-X-X-X-X-X-X-X and has been duly recorded in said office in Book No. X-X-X-X-X-X of Registration Statements on page X-X-X-X-X-X.~~

~~Construction shall be completed by X-X-X-X-X-X-X-X, 19X-X, and the water completely applied to X-X-X-X-X-X-X-X, 19X-X.~~

Witness my hand this _____ day of _____, 19_____.

 (State Engineer)

By: _____
 (Deputy)

Registration Statement

OF CLAIMANT OF RIGHT TO APPROPRIATE GROUND WATER

(Under Chapter 708, Oregon Laws 1955.)

TO THE STATE ENGINEER OF OREGON:

I, Doc L. Turridge
of REDI Jefferson County of Marion
State of Oregon, do hereby make application for a certificate of registration as evidence of a right to appropriate ground water.

- 1. Source from which water is withdrawn is pump well #6
(Flowing well, pump well, infiltration trench, or tunnel)
- 2. Location is: 3 mi. W of Jefferson Oregon
(Approximate distance and direction from nearest city or town)

and is more particularly described as follows:

- (a) 320' N + 1950' W of SE corner of Sec 34
(Give distance and bearing to corner of section or other legal subdivision)
- being within SW quarter of SE quarter of Sec. 34, Twp. 9 S, Rge. 3 W
(Smallest legal subdivision) (N. or S.) (E. or W.)
- or (b) within limits of recorded platted property, town or city:
- in Lot _____, Block _____ of _____
(Name of plat or addition)
- County of _____
(If within city or town, give name)

3. Construction Work was begun on 1936; was completed on 1956
(Date) (Date)

and the ground water claimed was first used for the purposes set out below on 1936
since which time the water has been used continuously
(Continuously or intermittently)
from 1936 to date
(Date) (Date)

4. Quantity of water claimed and used is 250 gallons per minute; 90 acre feet per year.

5. Purpose or Purposes for which water is used irrigation

(Domestic, irrigation, municipal, manufacturing, industrial, etc.)

6. Description of Well: Depth 40 feet. Type dug
(Dug or drilled)
diameter 5 inches. Elevation of ground at well site 225 feet, mean sea level.
(As near as known)

Depth to water table 16 feet.

7. Capacity of Well: _____ g.p.m. with _____ feet drawdown.
_____ g.p.m. with _____ feet drawdown.

Date of test _____

If Flowing Well: Measured discharge _____ g.p.m. on _____
(Date)

Shut-in pressure at ground surface _____ lbs. per sq. in. on _____
(Date)

Water is controlled by _____
(Cap, valve, etc.)

If log of well is not available, give name and address of driller.....

11. Infiltration Trench: Covered or open.....

Dimensions: Length ft. Minimum depth ft. Maximum depth ft.

Bottom width ft. Discharge g.p.m. Date of test

12. Tunnel: Type of lining.....

Dimensions:
(Length, course, and cross sectional size)

Position of water bearing stratum with reference to portal of tunnel.....

Log of tunnel: (Preceding table for log of well may be used, if desired. Give footage from portal and character of materials, as pertinent.)

13. Pumping Equipment:

(a) Pump FM Cent' 3x4 Capacity 450 g.p.m.
(Make, type and size)


(b) Motor 3 phase 220 15HP
(Type and horsepower)

14. Location of area irrigated or to be irrigated, or place of use if for purposes other than irrigation.

Township North or South	Range E. or W. of Willamette Meridian	Section	Forty-acre Tract	Number Acres To Be Irrigated	Date of Reclamation
95	3W	34	SE of SW	10	
			SW of SE	34	
			NW of SE	3	
			NE of SW	1	
105	3W	3	NW of NE	32	
			SW of NE	8	
			NE of NW	1	
				41	

15. If the ground water supply is supplemental to an existing water supply, identification of any application for a permit, permit, certificate or adjudicated right to appropriate water made or held by the registrant.

Township 4105 Range 310 W.M.
North

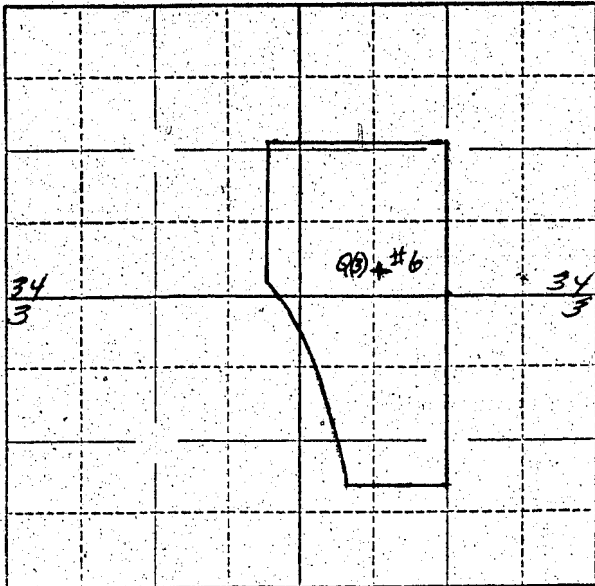

Locate well and acreage of irrigated land on plat.
Scale: $\frac{1}{4}$ " = 1 Mile

STATE OF OREGON }
County of _____ } ss.

I, _____, being first duly sworn, do hereby certify that I have read the foregoing Registration Statement and that all of the items therein contained are true to the best of my knowledge and belief.

(Signature of Registrant)

Subscribed and sworn to before me this _____ day of _____, 19_____

My commission expires _____ (Notary Public)

(SEAL)

See Page Gr-387 W for
CERTIFICATE OF REGISTRATION

STATE OF OREGON }
County of Marion } ss.

~~This is to certify that the foregoing Registration Statement was received in the office of the State Engineer on the _____ day of _____, 19____, at _____ o'clock _____ and has been duly recorded in said office in Book No. _____ of Registration Statements on page _____~~

~~Construction shall be completed by _____ 19____ and the water completely applied to beneficial use by _____ 19____~~

Witness my hand this _____ day of _____, 19_____

(State Engineer)

By _____ (Deputy)

Registration Statement

OF CLAIMANT OF RIGHT TO APPROPRIATE GROUND WATER

(Under Chapter 708, Oregon Laws 1955.)

TO THE STATE ENGINEER OF OREGON:

I, Rae L. Turridge
of BED I Jefferson County of Marion

State of Oregon, do hereby make application for a certificate of registration as evidence of a right to appropriate ground water.

- 1. Source from which water is withdrawn is pump well #1
(Flowing well, pump well, infiltration trench, or tunnel)
- 2. Location is: 3 mi W of Jefferson Oregon
(Approximate distance and direction from nearest city or town)

and is more particularly described as follows:

(a) 1025' S + 1900' W of NE corner of Sec. 3
(Give distance and bearing to corner of section or other legal subdivision)
being within NW quarter of Sec. 3 Twp. 10 S, Rge. 3 W
(Smallest legal subdivision) (N. or S.) (E. or W.)

or (b) within limits of recorded platted property, town or city:
in Lot _____, Block _____ of _____
(Name of plat or addition)

County of _____
(If within city or town, give name)

- 3. Construction Work was begun on 1936; was completed on 1936
(Date) (Date)

and the ground water claimed was first used for the purposes set out below on 1936
(Date)

since which time the water has been used continuously
(Continuously or intermittently)
from 1936 to date
(Date) (Date)

- 4. Quantity of water claimed and used is 150 gallons per minute; 60 acre feet per year.

- 5. Purpose or Purposes for which water is used irrigation
(Domestic, irrigation, municipal, manufacturing, industrial, etc.)

6. Description of Well: Depth 40 feet. Type drilled
(Dug or drilled)
diameter 8 inches. Elevation of ground at well site 225 feet, mean sea level.
(As near as known)
Depth to water table 16 feet.

- 7. Capacity of Well: _____ g.p.m. with _____ feet drawdown.
_____ g.p.m. with _____ feet drawdown.

Date of test _____

If Flowing Well: Measured discharge _____ g.p.m. on _____
(Date)

Shut-in pressure at ground surface _____ lbs. per sq. in. on _____
(Date)

Water is controlled by _____
(Cap, valve, etc.)

Registration Statement

OF CLAIMANT OF RIGHT TO APPROPRIATE GROUND WATER

(Under Chapter 708, Oregon Laws 1955.)

TO THE STATE ENGINEER OF OREGON:

I, Neil H. Turridge
of RED I. Jefferson County of Marion

State of Oregon, do hereby make application for a certificate of registration as evidence of a right to appropriate ground water.

- 1. Source from which water is withdrawn is pump well #8
(Flowing well, pump well, infiltration trench, or tunnel)
- 2. Location is: 3 mi. West of Jefferson, Ore.
(Approximate distance and direction from nearest city or town)

and is more particularly described as follows:

(a) 3280' S + 1975' W of NE corner of Sec 3
(Give distance and bearing to corner of section or other legal subdivision)
being within NW quarter of SE quarter of Sec 3 of 31 Twp. 10S Rge. 3W
(Smallest legal subdivision) (N. or S.) (E. or W.)

or (b) within limits of recorded platted property, town or city:

in Lot _____, Block _____ of _____
(Name of plat or addition)
County of _____
(If within city or town, give name)

3. Construction Work was begun on 1954; was completed on 1954
(Date) (Date)
and the ground water claimed was first used for the purposes set out below on 1955
(Date)
since which time the water has been used continuously
(Continuously or intermittently)
from 1955 to date
(Date) (Date)

4. Quantity of water claimed and used is 180 gallons per minute; 60 acre feet per year.

5. Purpose or Purposes for which water is used irrigation
(Domestic, irrigation, municipal, manufacturing, industrial, etc.)

6. Description of Well: Depth 30 feet. Type drilled
(Dug or drilled)
diameter 10 inches. Elevation of ground at well site 195 feet, mean sea level.
(As near as known)
Depth to water table 16 feet.

7. Capacity of Well: _____ g.p.m. with _____ feet drawdown.
_____ g.p.m. with _____ feet drawdown.
Date of test _____

If Flowing Well: Measured discharge _____ g.p.m. on _____
(Date)

Shut-in pressure at ground surface _____ lbs. per sq. in. on _____
(Date)

Water is controlled by _____
(Cap, valve, etc.)

Registration Statement

OF CLAIMANT OF RIGHT TO APPROPRIATE GROUND WATER

(Under Chapter 708, Oregon Laws 1955.)

TO THE STATE ENGINEER OF OREGON:

I, Robt. L. Turridge
of Red T. Jefferson County of Marion

State of Oregon, do hereby make application for a certificate of registration as evidence of a right to appropriate ground water.

- 1. Source from which water is withdrawn is pump well #4
(Flowing well, pump well, infiltration trench, or tunnel)
- 2. Location is: 3 mi West of Jefferson, Ore
(Approximate distance and direction from nearest city or town)

and is more particularly described as follows:

- (a) 1340' N. + 1975' W of S.E. corner of Sec 34
(Give distance and bearing to corner of section or other legal subdivision)
- being within NW 1/4 of Sec 34 of Sec. 34, Twp. 9 S, Rge. 3 W
(Smallest legal subdivision) (N. or S.) (E. or W.)
- or (b) within limits of recorded platted property, town or city:

in Lot, Block, of,
(Name of plat or addition)
County of

- 3. Construction Work was begun on 1954; was completed on 1954
(Date) (Date)

and the ground water claimed was first used for the purposes set out below on April - 1955,
(Date)

since which time the water has been used continuously
(Continuously or intermittently)

- 4. Quantity of water claimed and used is 200 gallons per minute; 90 acre
feet per year.

- 5. Purpose or Purposes for which water is used irrigation

- 6. Description of Well: Depth 32 feet. Type drilled
(Dug or drilled)
- diameter 12 inches. Elevation of ground at well site 205 feet, mean sea level.
(As near as known)
- Depth to water table 16 feet.

- 7. Capacity of Well: g.p.m. with feet drawdown.
- g.p.m. with feet drawdown.

Date of test

If Flowing Well: Measured discharge g.p.m. on

Shut-in pressure at ground surface lbs. per sq. in. on

Water is controlled by

If log of well is not available, give name and address of driller.

11. Infiltration Trench: Covered or open

Dimensions: Length ft. Minimum depth ft. Maximum depth ft.

Bottom width ft. Discharge g.p.m. Date of test

12. Tunnel: Type of lining

Dimensions:
(Length, course, and cross-sectional size)

Position of water bearing stratum with reference to portal of tunnel

Log of tunnel: (Preceding table for log of well may be used, if desired. Give footage from portal and character of materials, as pertinent.)

13. Pumping Equipment:

(a) Pump FM - Cent' - 3x4 Capacity 450 g.p.m.
(Make, type and size)


(b) Motor 3 ph 220 15HP
(Type and horsepower)

14. Location of area irrigated or to be irrigated, or place of use if for purposes other than irrigation.

Township North or South	Range E. or W. of Willamette Meridian	Section	Forty-acre Tract	Number Acres To Be Irrigated	Date of Reclamation
95	3W	34	SE of SW	10	April 1955
			SW of SE	84	
			NW of SE	3	
			NE of SW	1	
105	3W	3	NW of NE	32	-
			SW of NE	8	
			NE of NW	1	
				<u>89</u> Ac	

15. If the ground water supply is supplemental to an existing water supply, identification of any application for a permit, permit, certificate or adjudicated right to appropriate water made or held by the registrant.

Township 95 Range 3W W.M.
105 North

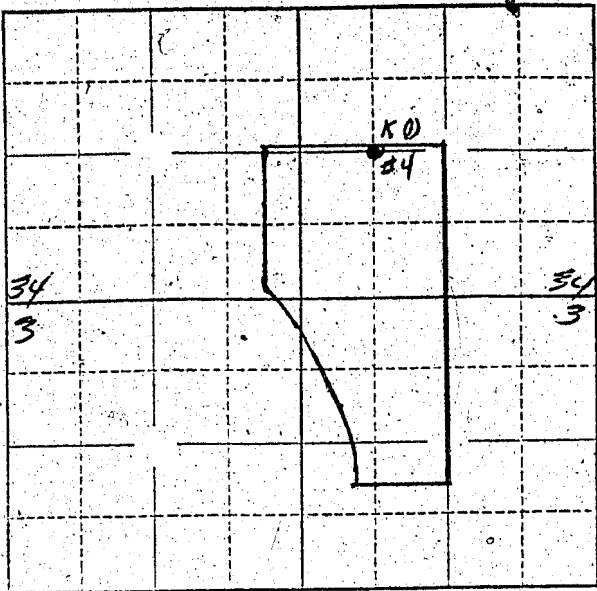

Locate well and acreage of irrigated land on plat.
 Scale: 1/4" = 1 Mile

STATE OF OREGON

County of _____ } ss.

I, _____, being first duly sworn, do hereby certify that I have read the foregoing Registration Statement and that all of the items therein contained are true to the best of my knowledge and belief.

 (Signature of Registrant)

Subscribed and sworn to before me this _____ day of _____, 19____.

My commission expires _____
 (Notary Public)

(SEAL)

See Page GR-387 W for
CERTIFICATE OF REGISTRATION

STATE OF OREGON

County of Marion } ss.

~~This is to certify that the foregoing Registration Statement was received in the office of the State Engineer on the X-X-X-X day of X-X-X-X 19X-X at X-X-X-X o'clock X-X-M and has been duly recorded in said office on Book No X-X-X-X of Registration Statements on page X-X-X-X-X
 Construction shall be completed by X-X-X-X 19-X-X and the water completely applied to beneficial use by X-X-X-X 19-X-X~~

Witness my hand this 23rd day of May, 1957

 (State Engineer)
 By _____
 (Deputy)

Registration Statement

OF CLAIMANT OF RIGHT TO APPROPRIATE GROUND WATER

(Under Chapter 708, Oregon Laws 1955.)

TO THE STATE ENGINEER OF OREGON:

I, Neil S. Thurridge
of RED T Jefferson County of Marion

State of Oregon do hereby make application for a certificate of registration as evidence of a right to appropriate ground water.

1. Source from which water is withdrawn is pump well #5
(Flowing well, pump well, infiltration trench, or tunnel)

2. Location is: 3 mi West of Jefferson, Ore.
(Approximate distance and direction from nearest city or town)

and is more particularly described as follows:

(a) 950' north & 1875' W of SE corner of Sec 34
(Give distance and bearing to corner of section or other legal subdivision)
being within SW 1/4 of SE 1/4 of Sec. 34, Twp. 9 S, Rge. 3 W
(Smallest legal subdivision) (N. or S.) (E. or W.)

or (b) within limits of recorded platted property, town or city: _____

in Lot _____, Block _____ of _____
(Name of plat or addition)

County of _____
(If within city or town, give name)

3. Construction Work was begun on 1938; was completed on 1938
(Date) (Date)

and the ground water claimed was first used for the purposes set out below on 1938
(Date)

since which time the water has been used continuously
(Continuously or intermittently)

from 1938 to date
(Date) (Date)

4. Quantity of water claimed and used is 400 gallons per minute; 25 acre feet per year.

5. Purpose or Purposes for which water is used irrigation

(Domestic, irrigation, municipal, manufacturing, industrial, etc.)

6. Description of Well: Depth 40 feet. Type drilled
(Dug or drilled)

diameter 8 inches. Elevation of ground at well site 995 feet, mean sea level.
(As near as known)

Depth to water table 16 feet.

7. Capacity of Well: _____ g.p.m. with _____ feet drawdown.

_____ g.p.m. with _____ feet drawdown.

Date of test _____

If Flowing Well: Measured discharge _____ g.p.m. on _____
(Date)

Shut-in pressure at ground surface _____ lbs. per sq. in. on _____
(Date)

Water is controlled by _____
(Csg, valve, etc.)

If log of well is not available, give name and address of driller.

11. Infiltration Trench: Covered or open

Dimensions: Length ft. Minimum depth ft. Maximum depth ft.

Bottom width ft. Discharge g.p.m. Date of test

12. Tunnel: Type of lining

Dimensions:
(Length, course, and cross sectional size)

Position of water bearing stratum with reference to portal of tunnel

Log of tunnel: (Preceding table for log of well may be used, if desired. Give footage from portal and character of materials, as pertinent.)

13. Pumping Equipment:

(a) Pump FM Cent' 2x3 Capacity 225 g.p.m.
(Make, type and size)


(b) Motor 3 phase 220 5HP
(Type and horsepower)

14. Location of area irrigated or to be irrigated, or place of use if for purposes other than irrigation.

Township North or South	Range E or W. of Willamette Meridian	Section	Forty-acre Tract	Number Acres To Be Irrigated	Date of Reclamation
95.	3W	34	SW of SE	10	1938

15. If the ground water supply is supplemental to an existing water supply, identification of any application for a permit, permit, certificate or adjudicated right to appropriate water made or held by the registrant.

Township 95 Range 3W, W.M.
105 North

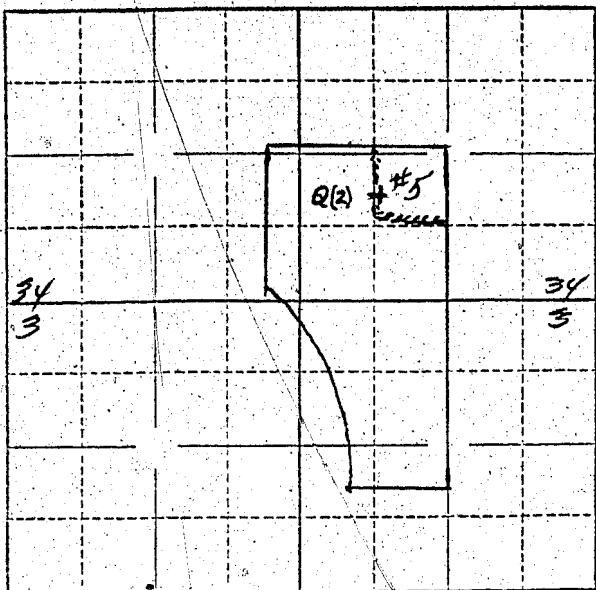

Locate well and acreage of irrigated land on plat.

Scale: 1/4 - 1 Mile

STATE OF OREGON

County of Marion } ss.

I, Paul L. Turnidge, being first duly sworn, do hereby certify that I have read the foregoing Registration Statement and that all of the items therein contained are true to the best of my knowledge and belief.

Paul L. Turnidge
(Signature of Registrant)

Subscribed and sworn to before me this 20 day of March, 1957.

My commission expires September 2, 1960

Mar. F. Moore
(Notary Public)

(SEAL)

CERTIFICATE OF REGISTRATION

STATE OF OREGON

County of Marion } ss.

This is to certify that the foregoing Registration Statement was received in the office of the State Engineer on the 20th day of March, 1957 at 2:30 o'clock P. M. and has been duly recorded in said office in Book No. 3 of Registration Statements on page Gth-387 W

~~XX Construction shall be completed by X-X-X-X-X-X-X-X-X-X-X-X-X-X-X-X and the water completely applied to X-X-X-X-X-X-X-X-X-X-X-X-X-X-X-X~~

Witness my hand this 23rd day of May, 1957.

Levins A. Otterley
(State Engineer)

By _____ (Deputy)

GR 387 W

#3830