

RECEIVED
AUG 12 1958

STATE ENGINEER
SALE... OREGON

Registration Statement

Registration No. GR-4048

Certificate No. GR-3649

OF CLAIMANT OF RIGHT TO APPROPRIATE GROUND WATER

TO THE STATE ENGINEER OF OREGON:

I, Willis D Jones

of Rt 1 Box 89 Jefferson County of Marion

State of Oregon, do hereby make application for a certificate of registration as evidence of a right to appropriate ground water.

1. Source from which water is withdrawn is Pump Well
(Flowing well, pump well, infiltration trench, or tunnel)

2. Location is: 9 miles North West of Jefferson
(Approximate distance and direction from nearest city or town)

and is more particularly described as follows:

(a) 150' E & 100' N from center section 18
(Give distance and bearing to corner of section or other legal subdivision)

being within S 1/4 NE 1/4 of Sec. 18, Twp. 9S, Rge. 3W
(Smallest legal subdivision) (N. or S.) (E. or W.)

or within limits of recorded platted property, town or city:

in Lot _____, Block _____ of _____
(Name of plat or addition)

County of _____
(If within city or town, give name)

3. Construction Work was begun on 1947; was completed on 1947
(Date) (Date)

and the ground water claimed was first used for the purposes set out below on 1947
(Date)

since which time the water has been used Continuously
(Continuously or intermittently)

from May to Aug
(Date) (Date)

4. Quantity of water claimed and used is 90 gallons per minute; _____ acre feet per year.

5. Purpose or Purposes for which water is used irrigation
(Domestic, irrigation, municipal, manufacturing, industrial, etc.)

6. Description of Well: Depth 44 feet. Type Drilled
(Dug or drilled)

diameter 6 inches. Elevation of ground at well site _____ feet, mean sea level.
(As near as known)

Depth to water table 17 feet.

7. Capacity of Well: 90 g.p.m. with stays at 17 feet feet drawdown.

_____ g.p.m. with _____ feet drawdown.

Date of test _____

If Flowing Well: Measured discharge Never tested g.p.m. on _____
(Date)

Shut-in pressure at ground surface _____ lbs. per sq. in. on _____
(Date)

Water is controlled by _____
(Cap, valve, etc.)

8. Casing: (Give diameter, commercial specifications and depth below ground surface of each casing size.)

6 inch diameter from ground level from to 44 feet
inch diameter from to feet
inch diameter from to feet
inch diameter from to feet

Describe and show depth of shoe, plug, adapter, liner or other details:

9. Perforated Casings or Screens:

Perforated don't know how much from to
(Number per foot and size of perforations, or describe screen)
from to
from to
from to

10. Log of Well: (Describe each stratum or formation clearly, indicate if water bearing, and give thickness and depth as indicated.)

MATERIAL	Thickness (Feet)	Depth to Bottom (Feet)

If log of well is not available, give name and address of driller. do not know

11. Infiltration Trench: Covered or open: _____

Dimensions: Length _____ ft. Minimum depth _____ ft. Maximum depth _____ ft.

Bottom width _____ ft. Discharge _____ g.p.m. Date of test _____

12. Tunnel: Type of lining _____

Dimensions: _____
(Length, course, and cross sectional size)

Position of water bearing stratum with reference to portal of tunnel _____

Log of tunnel: (Preceding table for log of well may be used, if desired. Give footage from portal and character of materials, as pertinent.)

13. Pumping Equipment:

(a) Pump Jacuzzi Capacity 90 g.p.m.
(Make, type and size)

(b) Motor General Electric 5 hp.
(Type and horsepower)


14. Location of area irrigated or to be irrigated, or place of use if for purposes other than irrigation.

Township North or South	Range E. or W. of Willamette Meridian	Section	Forty-acre Tract	Number Acres To Be Irrigated	Date of Reclamation
9S	3W	18	SW $\frac{1}{4}$ NE $\frac{1}{4}$	1	1947
"	"	"	NE $\frac{1}{4}$ SW $\frac{1}{4}$	1	"
"	"	"	NW $\frac{1}{4}$ SE $\frac{1}{4}$	4	"
				<u>6</u>	

15. If the ground water supply is supplemental to an existing water supply, identification of any application for a permit, permit, certificate or adjudicated right to appropriate water made or held by the registrant.

Section 18

Township 9S Range 3W W.M.
North

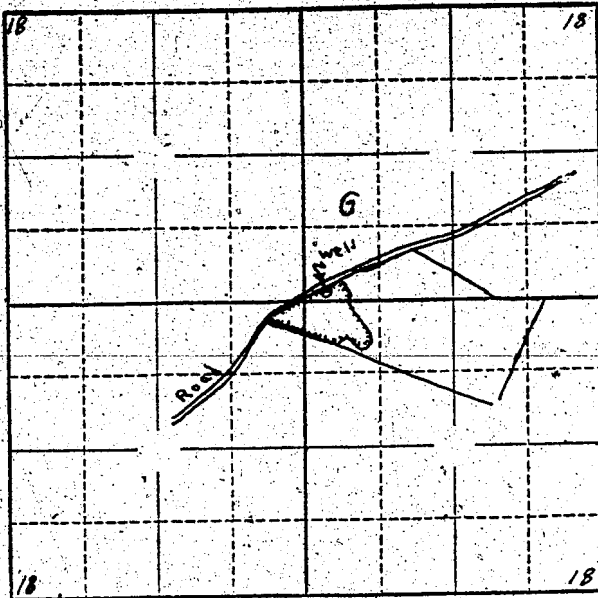

Locate well and acreage of irrigated land on plat.

Scale: $\frac{1}{4}$ " = 1 Mile

STATE OF OREGON

County of Marion } ss.

I, Willis D. Jones, being first duly sworn, do hereby certify that I have read the foregoing Registration Statement and that all of the items therein contained are true to the best of my knowledge and belief.

Willis D. Jones
(Signature of Registrant)

Subscribed and sworn to before me this 25th day of July, 1957

My commission expires _____

Clayton A. Shores
(Notary Public)
MY COMMISSION EXPIRES JULY 25, 1960

(SEAL)

CERTIFICATE OF REGISTRATION

STATE OF OREGON

County of Marion } ss.

This is to certify that the foregoing Registration Statement was received in the office of the State Engineer on the 4th day of August, 1957, at 8:00 o'clock A. M. and has been duly recorded in said office in Book No. 15 of Registration Statements on page GR 3649

Witness my hand this 20th day of October, 1959

Luvis A. Stanley
(State Engineer)

By _____ (Deputy)

#15.00

GR 3649