

Registration Statement

OF CLAIMANT OF RIGHT TO APPROPRIATE GROUND WATER

TO THE STATE ENGINEER OF OREGON:

I, Otis Phillips
of R 2 Box 450, Salem County of Marion
(Mailing address)

State of Oregon, do hereby make application for a certificate of registration as evidence of a right to appropriate ground water.

1. Source from which water is withdrawn is PUMP
(Flowing well, pump well, infiltration trench, or tunnel)

2. Location is: 2 1/2 mi East of Brooks 3rd St.
(Approximate distance and direction from nearest city or town)

and is more particularly described as follows: 1530' W x 808' S from NE Corner Section 28

(a) 1/2 mi from North East Corner, Section 28
(Give distance and bearing to corner of section or other legal subdivision)

being within NW 1/4 NE 1/4 of Sec. 28, Twp. 6S, Rge. 2 W.
(Smallest legal subdivision) (N. or S.) (E. or W.)

or (b) within limits of recorded platted property, town or city:

in Lot _____, Block _____ of _____
(Name of plat or addition)

County of _____
(If within city or town, give name)

3. Construction Work was begun on 4/1954; was completed on 4/1954
(Date) (Date)

and the ground water claimed was first used for the purposes set out below on 1954
(Date)

since which time the water has been used Intermittently
(Continuously or Intermittently)

from 1954 to 1958
(Date) (Date)

4. Quantity of water claimed and used is 65 gallons per minute; _____ acre feet per year.

5. Purpose or Purposes for which water is used Farming

Irrigation
(Domestic, irrigation, municipal, manufacturing, industrial, etc.)

6. Description of Well: Depth 57 feet. Type Drilled
(Case drilled)

diameter 6 inches. Elevation of ground at well site 190 feet, mean sea level.
(As near as known)

Depth to water table 13 feet.

7. Capacity of Well: 300 g.p.m. with 4 feet drawdown.
_____ g.p.m. with _____ feet drawdown.

Date of test no test

If Flowing Well Measured discharge _____ g.p.m. on _____
(Date)

Shut-in pressure at ground surface _____ lbs. per sq. in. on _____
(Date)

Water is controlled by _____
(Cap, valve, etc.)

8. Casing: (Give diameter, commercial specifications and depth below ground surface of each casing size.)

6 inch diameter from top to 57 feet
inch diameter from to feet
inch diameter from to feet
inch diameter from to feet

Describe and show depth of shoe, plug, adapter, liner or other details:

9. Perforated Casings or Screens:

from to
(Number per foot and size of perforations, or describe screen)
from to
from to
from to

10. Log of Well: (Describe each stratum or formation clearly, indicate if water bearing, and give thickness and depth as indicated.)

MATERIAL	Thickness (Feet)	Depth to Bottom (Feet)
not sample		

If log of well is not available, give name and address of driller. Orville Wymore

Sate Brooks

11. Infiltration Trench: Covered or open _____

Dimensions: Length _____ ft. Minimum depth _____ ft. Maximum depth _____ ft.

Bottom width _____ ft. Discharge _____ g.p.m. Date of test _____

12. Tunnel: Type of lining _____

Dimensions: _____
(Length, course, and cross sectional size)

Position of water bearing stratum with reference to portal of tunnel _____

Log of tunnel: (Preceding table for log of well may be used, if desired. Give footage from portal and character of materials, as pertinent.)

13. Pumping Equipment:

(a) Pump Waterhorse, centrifugal Capacity 65 g.p.m.
(Make, type and size)

(b) Motor Single Phase 5 Electric
(Type and horsepower)


14. Location of area irrigated or to be irrigated, or place of use if for purposes other than irrigation.

Township North or South	Range E. or W. of Willamette Meridian	Section	Four-acre Tract	Number Acres To Be Irrigated	Date of Reclamation
<u>T6S</u>	<u>2 W</u>	<u>28</u>	<u>NW¹NE⁴</u>	<u>3.2</u>	<u>1954</u>

15. If the ground water supply is supplemental to an existing water supply, identification of any application for a permit, permit, certificate or adjudicated right to appropriate water made or held by the registrant.

None

Township ^{6.S} ~~6.S~~ Range 2.W W.M.
North

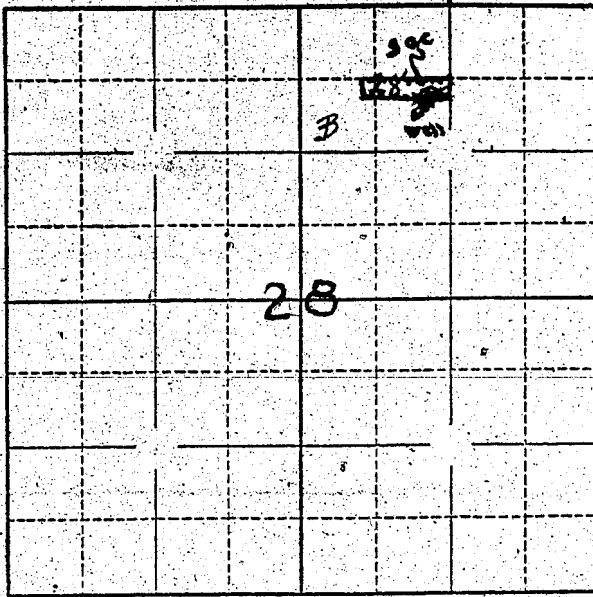

Locate well and acreage of irrigated land on plat.

Scale: ~~1/2~~ - 1 Mile

40

STATE OF OREGON

County of Marion } ss.

I, Otis Phillips, being first duly sworn, do hereby certify that I have read the foregoing Registration Statement and that all of the items therein contained are true to the best of my knowledge and belief.

Otis Phillips
(Signature of Registrant)

Subscribed and sworn to before me this 4th day of August, 1958

My commission expires 12th June 1961 Wm. S. Bartholomew
(Notary Public)

(SEAL)

CERTIFICATE OF REGISTRATION

STATE OF OREGON } ss.
County of Marion

This is to certify that the foregoing Registration Statement was received in the office of the State Engineer on the 4 day of August, 1958 at 2.00 o'clock P. M. and has been duly recorded in said office in Book No. 15 of Registration Statements on page GR 3656

Witness my hand this 20th day of October, 1959

Laura A. Stanley
(State Engineer)

By _____ (Deputy)

9/15/59

GR 3656