

RECEIVED
AUG 4 1958

Registration No. GR-4059

Certificate No. GR-3659

Registration Statement

OF CLAIMANT OF RIGHT TO APPROPRIATE GROUND WATER

TO THE STATE ENGINEER OF OREGON:

I, WALLACE WHITELEY
of 1440 RIVER LOOP I EUGENE County of LANE
(Mailing address)

State of ORE, do hereby make application for a certificate of registration as evidence of a right to appropriate ground water.

- Source from which water is withdrawn is PUMP WELL
(Flowing well, pump well, infiltration trench, or tunnel)
- Location is: 3 Miles North of Eugene
(Approximate distance and direction from nearest city or town)

and is more particularly described as follows:

(a) 2050 Ft North and 1160 Ft West from South East corner of Section 1
(Give distance and bearing to corner of section or other legal subdivision)
being within NE 1/4 of S 1/4 of Sec. 1, Twp. 17S, Rge. 4W.
(Smallest legal subdivision) (N. or S.) (E. or W.)

or (b) within limits of recorded platted property, town or city: _____
in Lot _____, Block _____ of _____
(Name of plat or addition)

County of _____
(If within city or town, give name)

- Construction Work was begun on 1948; was completed on 1948
(Date) (Date)

and the ground water claimed was first used for the purposes set out below on 1948
since which time the water has been used Intermittently ✓
(Continuously or Intermittently)
from APRIL to OCT
(Date) (Date)

- Quantity of water claimed and used is 150 gallons per minute; 15 acre feet per year.

5. Purpose or Purposes for which water is used IRRIG
(Domestic, irrigation, municipal, manufacturing, industrial, etc.)

6. Description of Well: Depth 21 feet. Type DROVE
(Dug or drilled)
diameter 2 inches. Elevation of ground at well site _____ feet, mean sea level.
(As near as known)
Depth to water table 15 feet.

- Capacity of Well: _____ g.p.m. with _____ feet drawdown.
_____ g.p.m. with _____ feet drawdown.

Date of test NO TEST

If Flowing Well: Measured discharge _____ g.p.m. on _____
(Date)

Shut-in pressure at ground surface _____ lbs. per sq. in. on _____
(Date)

Water is controlled by _____
(Cap, valve, etc.)

8. Casing: (Give diameter, commercial specifications and depth below ground surface of each casing size.)

2 inch diameter from 0 to 21 feet
 inch diameter from to feet
 inch diameter from to feet
 inch diameter from to feet

Describe and show depth of shoe, plug, adapter, liner or other details:

.....

.....


9. Perforated Casings or Screens:

Shot End off from to
(Number per foot and size of perforations, or describe screen)
 from to
 from to
 from to

10. Log of Well: (Describe each stratum or formation clearly, indicate if water bearing, and give thickness and depth as indicated.)

MATERIAL	Thickness (Feet)	Depth to Bottom (Feet)
NONE		

Township 17S Range 4W, W.M.
North

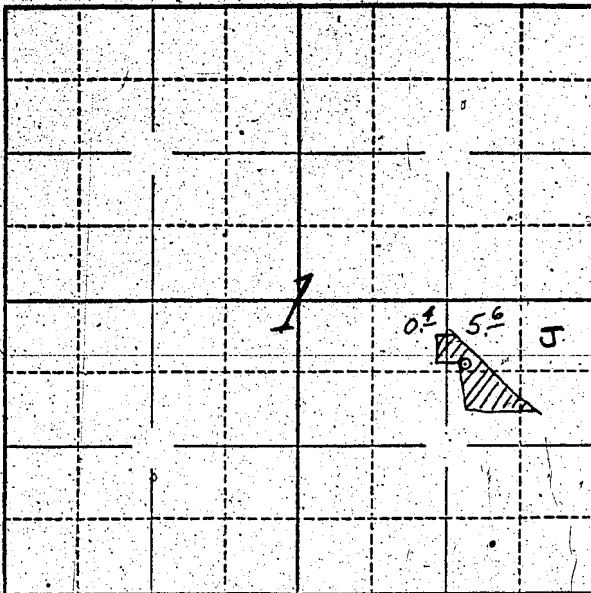

Locate well and acreage of irrigated land on plat.
Scale: $\frac{1}{2}$ - 1 Mile

STATE OF OREGON

County of Lane } ss.

I, Wallace Whiteley, being first duly sworn, do hereby certify that I have read the foregoing Registration Statement and that all of the items therein contained are true to the best of my knowledge and belief.

Wallace Whiteley
(Signature of Registrant)

Subscribed and sworn to before me this 3rd day of August, 1955

My commission expires May 8th 1961

John B. ...
(Notary Public)

(SEAL)

CERTIFICATE OF REGISTRATION

STATE OF OREGON

County of Marion } ss.

This is to certify that the foregoing Registration Statement was received in the office of the State Engineer on the 4th day of August, 1955, at 7:00 o'clock A.M. and has been duly recorded in said office in Book No. 15 of Registration Statements on page GR-3659

Witness my hand this 20th day of October, 1959

\$ 15.00

Lewis A. Stanley
(State Engineer)

By _____
(Deputy)

GR 3659