

Registration Statement

REGISTRATION NO. GP-407  
CERTIFICATE NO. 390

OF CLAIMANT OF RIGHT TO APPROPRIATE GROUND WATER

(Under Chapter 708, Oregon Laws 1955.)

TO THE STATE ENGINEER OF OREGON:

I, Clark Noble, Rt 1, Box 203  
of Jamhill County of Dayton

State of Oregon, do hereby make application for a certificate of registration as evidence of a right to appropriate ground water.

1. Source from which water is withdrawn is Pump Well  
(Flowing well, pump well, infiltration trench, or tunnel)

2. Location is: 1.2 miles Southeast of Dayton  
(Approximate distance and direction from nearest city or town)

and is more particularly described as follows:

(a) S 220° 41' 26" 555 ft from NE corner of Sec 26  
(Give distance and bearing to corner of section or other legal subdivision)

being within N.E. 1/4 of the N.E. 1/4 of Sec. 26 Twp. 5 S, Rge. 3 W  
(Smallest legal subdivision) (N. or S.) (E. or W.)

or (b) within limits of recorded platted property, town or city:

in Lot \_\_\_\_\_, Block \_\_\_\_\_ of \_\_\_\_\_  
(Name of plat or addition)

County of \_\_\_\_\_  
(If within city or town, give name)

3. Construction Work was begun on May 17, 1954, was completed on June 22, 1954  
(Date) (Date)

and the ground water claimed was first used for the purposes set out below on June 1, 1954  
(Date)

since which time the water has been used Intermittently  
(Continuously or intermittently)

from June 1, 1954 to Oct 1, 1956  
(Date) (Date)

4. Quantity of water claimed and used is 350 gallons per minute; \_\_\_\_\_ acre feet per year.

5. Purpose or Purposes for which water is used \_\_\_\_\_

Irrigation  
(Domestic, irrigation, municipal, manufacturing, industrial, etc.)

6. Description of Well: Depth 32 feet. Type Drilled  
(Dug or drilled)

diameter 12 inches. Elevation of ground at well site 98 feet, mean sea level.  
(As near as known)

Depth to water table 1.2 feet.

7. Capacity of Well: 700 g.p.m. with 3 feet drawdown.

\_\_\_\_\_ g.p.m. with \_\_\_\_\_ feet drawdown.

Date of test, May 22, 1954

If Flowing Well: Measured discharge \_\_\_\_\_ g.p.m. on \_\_\_\_\_  
(Date)

Shut-in pressure at ground surface \_\_\_\_\_ lbs. per sq. in. on \_\_\_\_\_  
(Date)

Water is controlled by \_\_\_\_\_  
(Cap, valve, etc.)

8. Casing: (Give diameter, commercial specifications and depth below ground surface of each casing size.)

31.20# Black Std. Pipe

10 inch diameter Tap to 32 ft. from 0 to 32 feet

inch diameter from to feet

inch diameter from to feet

inch diameter from to feet

Describe and show depth of shoe, plug, adapter, liner or other details:

Spring & Test at Base (Welded)

9. Perforated Casings or Screens:

Per Perforated with mesh before Installation from 15 ft to 32 ft

(Number per foot and size of perforations, or describe screen)

from to

from to

from to

10. Log of Well: (Describe each stratum or formation clearly, indicate if water bearing, and give thickness and depth as indicated.)

MATERIAL	Thickness (Feet)	Depth to Bottom (Feet)
Sandy top soil	15	15
Coarse brownish sand (Water)	17	32

If log of well is not available, give name and address of driller.

*William H. Knilling Co., R. 2, Box 333, Halem, Ore.*

11. Infiltration Trench: Covered or open

Dimensions: Length ft. Minimum depth ft. Maximum depth ft.

Bottom width ft. Discharge g.p.m. Date of test

12. Tunnel: Type of lining

Dimensions: (Length, course, and cross sectional size)

Position of water bearing stratum with reference to portal of tunnel

Log of tunnel: (Preceding table for log of well may be used, if desired. Give footage from portal and character of materials, as pertinent.)

13. Pumping Equipment:

(a) Pump *Pacific Centrifugal 3x4* Capacity: *350* g.p.m.  
(Make, type and size)


(b) Motor *2.5 H.P.*  
(Type and horsepower)

14. Location of area irrigated or to be irrigated, or place of use if for purposes other than irrigation.

Township North or South	Range E. or W. of Willamette Meridian	Section	Forty-acre Tract	Number Acres To Be Irrigated	Date of Reclamation
<i>5S</i>	<i>32E</i>	<i>23</i>	<i>SE 40 SE 1/4</i>	<i>7.50</i>	<i>June 1954</i>
<i>5S</i>	<i>32E</i>	<i>24</i>	<i>NE 40 NE 1/4</i>	<i>2.7</i>	<i>"</i>
<i>5S</i>	<i>32W</i>	<i>24</i>	<i>SE 40 NE 1/4</i>	<i>7</i>	<i>"</i>
<i>5S</i>	<i>3W</i>	<i>25</i>	<i>SE 40 NW 1/4</i>	<i>2.87</i>	<i>"</i>
<i>5S</i>	<i>3W</i>	<i>25</i>	<i>NW 40 NE 1/4</i>	<i>10</i>	<i>"</i>
				<i>504.67 Total</i>	

15. If the ground water supply is supplemental to an existing water supply, identification of any application for a permit, permit, certificate or adjudicated right to appropriate water made or held by the registrant.

Township 5 S Range 9 W W.M.  
North

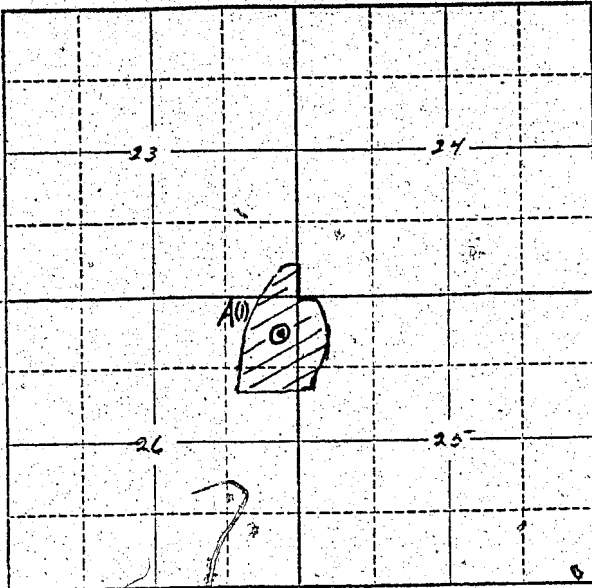

Locate well and acreage of irrigated land on plat.  
Scale: 2" = 1 Mile

STATE OF OREGON }  
County of Hemlock } ss.

I, CLARK NOBLE, being first duly sworn, do hereby certify that I have read the foregoing Registration Statement and that all of the items therein contained are true to the best of my knowledge and belief.

Clark Noble  
(Signature of Registrant)

Subscribed and sworn to before me this 30 day of March, 19 57

My commission expires Sept 19 1959

Virginia M. Galme  
(Notary Public)

(SEAL)

**CERTIFICATE OF REGISTRATION**

STATE OF OREGON }  
County of Marion } ss.

This is to certify that the foregoing Registration Statement was received in the office of the State Engineer on the 20th day of March, 19 57, at 10:30 o'clock A. M. and has been duly recorded in said office in Book No. 3 of Registration Statements on page GR-390 C

~~XV Construction shall be completed by X-X-X-X-X-X-X-X-X-X-X-X-X-X-X-X and the water completely applied to beneficial use by X-X-X-X-X-X-X-X-X-X-X-X-X~~

Witness my hand this 23rd day of May, 19 57

Leura A. Stanley  
(State Engineer)

\$ 18 <sup>75</sup>

By \_\_\_\_\_  
(Deputy)