

RECEIVED  
AUG 1, 1958  
STATE ENGINEER  
SALEM, OREGON

Registration No. GR-4074

Certificate No. GR-3670

# Registration Statement

## OF CLAIMANT OF RIGHT TO APPROPRIATE GROUND WATER

TO THE STATE ENGINEER OF OREGON:

I, RALPH H. LANE

of RTE 4, Box 217, Mildred Lane, Salem, County of MARION  
(Mailing address)

State of OREGON, do hereby make application for a certificate of registration as evidence of a right to appropriate ground water.

1. Source from which water is withdrawn is PUMP WELL  
(Flowing well, pump well, infiltration trench, or tunnel)

2. Location is: 6 MILES SOUTH OF SALEM  
(Approximate distance and direction from nearest city or town)

and is more particularly described as follows:

(a) SOUTH 259' & EAST 182' FROM 1/4 COR. ON WEST LINE SEC. 15  
(Give distance and bearing to corner of section or other legal subdivision)

being within S.W. 1/4 & N.W. 1/4 of Sec. 15, Twp. 8 S, Rge. 3 W  
(Smallest legal subdivision) (N. or S.) (E. or W.)

or (b) within limits of recorded platted property, town or city:

in Lot 7, Block - of LEN'S HILL FRUIT TRACTS  
(Name of plat or addition)

Salem County of MARION  
(If within city or town, give name)

3. Construction Work was begun on SEPTEMBER 1950, was completed on SEPTEMBER 1950  
(Date) (Date)

and the ground water claimed was first used for the purposes set out below on JANUARY 1951,  
(Date)

since which time the water has been used CONTINUOUSLY  
(Continuously or intermittently)

from JANUARY 1951 to AUGUST 1958  
(Date) (Date)

4. Quantity of water claimed and used is 20-22 gallons per minute; \_\_\_\_\_ acre feet per year.

5. Purpose or Purposes for which water is used (exempt) IRRIGATION  
DOMESTICALLY

(Domestic, irrigation, municipal, manufacturing, industrial, etc.)

6. Description of Well: Depth 96 feet. Type DRILLED  
(Dug or drilled)

diameter 6" inches. Elevation of ground at well site 400 feet, mean sea level.  
(As near as known)

Depth to water table 86 feet.

7. Capacity of Well: 10-22 g.p.m. with UNKNOWN feet drawdown.

\_\_\_\_\_ g.p.m. with \_\_\_\_\_ feet drawdown.

Date of test SEPTEMBER 1950

If Flowing Well: Measured discharge \_\_\_\_\_ g.p.m. on \_\_\_\_\_ (Date)

Shut-in pressure at ground surface \_\_\_\_\_ lbs. per sq. in. on \_\_\_\_\_ (Date)

Water is controlled by \_\_\_\_\_  
(Cap, valve, etc.)

NO EVIDENCE OF LACK OF WATER SUPPLY AFTER CONSTANT RUNNING FOR SEVERAL HOURS

8. Casing: (Give diameter, commercial specifications and depth below ground surface of each casing size.)

6" inch diameter from SURFACE to 8.6 feet  
 inch diameter from to feet  
 inch diameter from to feet  
 inch diameter from to feet

Describe and show depth of shoe, plug, adapter, liner or other details:  
 \_\_\_\_\_  
 \_\_\_\_\_

9. Perforated Casings or Screens:

(Number per foot and size of perforations, or describe screen) from to  
 from to  
 from to  
 from to

10. Log of Well: (Describe each stratum or formation clearly, indicate if water bearing, and give thickness and depth as indicated.)

MATERIAL	Thickness (Feet)	Depth to Bottom (Feet)
DIRT	8.6	8
LAVA BED	1.0	

If log of well is not available, give name and address of driller. DUFFIELD BROS.  
4045 BLUFF S.E., SALEM, OREGON

11. Infiltration Trench: Covered or open \_\_\_\_\_  
 Dimensions: Length \_\_\_\_\_ ft. Minimum depth \_\_\_\_\_ ft. Maximum depth \_\_\_\_\_ ft.

Bottom width \_\_\_\_\_ ft. Discharge \_\_\_\_\_ g.p.m. Date of test \_\_\_\_\_

12. Tunnel: Type of lining \_\_\_\_\_

Dimensions: \_\_\_\_\_  
(Length, course, and cross sectional size)

Position of water bearing stratum with reference to portal of tunnel \_\_\_\_\_

Log of tunnel: (Preceding table for log of well may be used, if desired. Give footage from portal and character of materials, as pertinent.)

13. Pumping Equipment:

(a) Pump HOMART JET PUMP Capacity 25 g.p.m.  
(Make, type and size)

(b) Motor 1 1/2 HORSEPOWER  
(Type and horsepower)


14. Location of area irrigated or to be irrigated, or place of use if for purposes other than irrigation.

Township North or South	Range E. or W. of Willamette Meridian	Section	Forty-acre Tract	Number Acres To Be Irrigated	Date of Reclamation
T85	R3W	15	N.W. 1/4 of N.W. 1/4	3.68	1951
T85	R3W	15	S.W. 1/4 of N.W. 1/4	2.73	"
			<u>total acres</u>	<u>6.41</u>	"

15. If the ground water supply is supplemental to an existing water supply, identification of any application for a permit, permit, certificate or adjudicated right to appropriate water made or held by the registrant.

Township 85 Range 3W W.M.

North

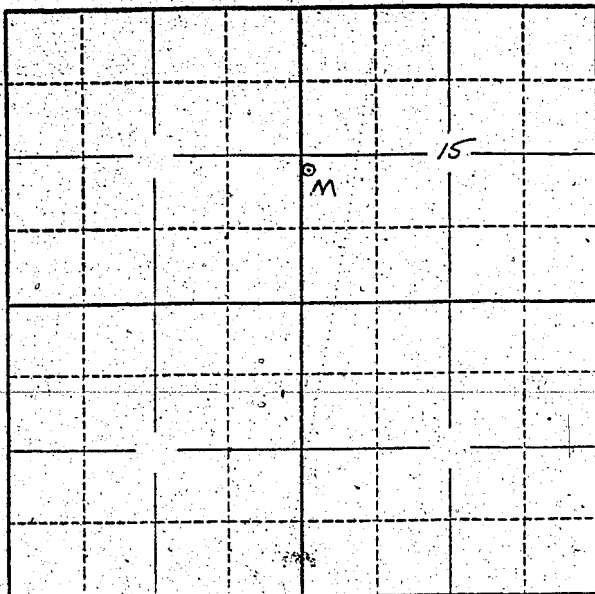

SEE  
IRRIGATION  
MAP  
ATTACHED

Locate well and acreage of irrigated land on plat.  
Scale: 2" = 1 Mile

STATE OF OREGON

County of MARION } ss.

I, RALPH H. LANE, being first duly sworn, do hereby certify that I have read the foregoing Registration Statement and that all of the items therein contained are true to the best of my knowledge and belief.

Ralph H. Lane  
(Signature of Registrant)

Subscribed and sworn to before me this 14 day of August, 1958

My commission expires 6 March 1962 Richard E. Grubbs  
(Notary Public)

(SEAL)

**CERTIFICATE OF REGISTRATION**

STATE OF OREGON

County of Marion } ss.

This is to certify that the foregoing Registration Statement was received in the office of the State Engineer on the 4 day of August, 1958, at 8.00 o'clock A.M. and has been duly recorded in said office in Book No. 15 of Registration Statements on page GR-3670

Witness my hand this 20<sup>th</sup> day of October, 1959

Lewis A. Stanley  
(State Engineer)

By \_\_\_\_\_ (Deputy)

\$15.00

GR 3670