

RECEIVED
AUG 4 1958

Registration Statement

Registration No. GR-4077
Certificate No. GR-3673

STATE ENGINEER
SALEM, OREGON CLAIMANT, OF RIGHT TO APPROPRIATE GROUND WATER

TO THE STATE ENGINEER OF OREGON:

I, E.E. Cone (Cone Lumber Co.)
of Goshen, Oregon County of Lane
(Mailing address)

State of Oregon, do hereby make application for a certificate of registration as evidence of a right to appropriate ground water.

1. Source from which water is withdrawn is Pump well #1
(Flowing well, pump well, infiltration trench, or tunnel)

2. Location is: 1/4 mile south of Goshen
(Approximate distance and direction from nearest city or town)

and is more particularly described as follows:

(a) 1350 feet south & 1500 feet west from NE corner Section 23
(Give distance and bearing to corner of section or other legal subdivision)

being within SW 1/4 NE 2 of Sec. 23 Twp. 18S, Rge. 2W
(Smallest legal subdivision) (S. or N.) (E. or W.)

or (b) within limits of recorded platted property, town or city:

in Lot _____, Block _____ of _____
(Name of plat or addition)
County of _____
(If within city or town, give name)

3. Construction Work was begun on Aug. 1948 (approx) was completed on same 1948
(Date) (Date)

and the ground water claimed was first used for the purposes set out below on same 1948
(Date) (Date)

since which time the water has been used continuously
(Continuously or intermittently)

from JANUARY to JANUARY
(Date) (Date)

4. Quantity of water claimed and used is 40 gallons per minute; 2 acre feet per year.

5. Purpose or Purposes for which water is used Industrial

(Domestic, irrigation, municipal, manufacturing, industrial, etc.)

6. Description of Well: Depth _____ feet. Type Grilled
(Dug or drilled)

diameter 5" inches. Elevation of ground at well site 350 feet, mean sea level.
(As near as known)

Depth to water table unknown feet.

7. Capacity of Well: unknown g.p.m. with _____ feet drawdown.

_____ g.p.m. with _____ feet drawdown.


Date of test _____

If Flowing Well: Measured discharge _____ g.p.m. on _____
(Date)

Shut-in pressure at ground surface _____ lbs. per sq. in. on _____
(Date)

Water is controlled by _____
(Cap, valve, etc.)

Township 18S Range 3W, W.M.
North

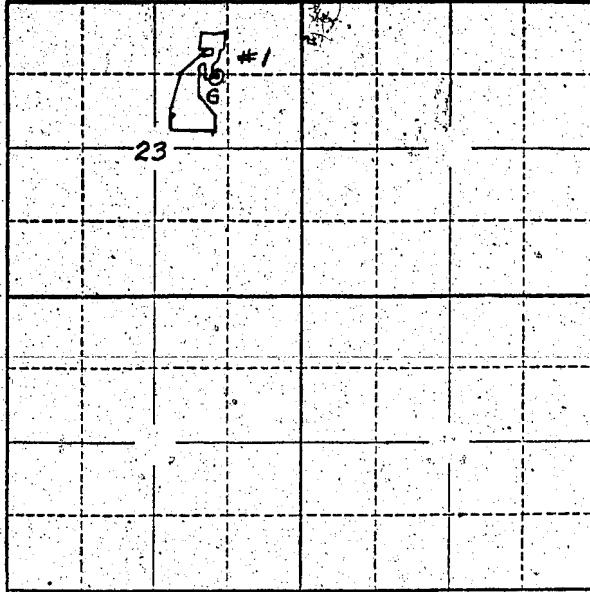

well

Locate well and acreage of irrigated land on plat.
Scale: 2" = 1 Mile

STATE OF OREGON

County of Lane } ss.

I, E. E. Cone, being first duly sworn, do hereby certify that I have read the foregoing Registration Statement and that all of the items therein contained are true to the best of my knowledge and belief.

E. E. Cone
(Signature of Registrant)

Subscribed and sworn to before me this 1st day of August, 1958.

My commission expires 2/16/62
Roberta D. Robertson
(Notary Public)

(SEAL)

CERTIFICATE OF REGISTRATION

STATE OF OREGON } ss.
County of Marion

This is to certify that the foregoing Registration Statement was received in the office of the State Engineer on the 4th day of August, 1958 at 8:00 o'clock A. M. and has been duly recorded in said office in Book No. 15 of Registration Statements on page or 3673

Witness my hand this 20th day of October, 1959.

Lawrence A. Stanley
(State Engineer)

By _____
(Deputy)

\$ 20.00

GR 3673