

Registration Statement CERTIFICATE NO. R-391

OF CLAIMANT OF RIGHT TO APPROPRIATE GROUND WATER

(Under Chapter 708, Oregon Laws 1955.)

TO THE STATE ENGINEER OF OREGON:

I, W. J. Calvert

of R#213 of 449 Eugene County of Lane

State of Oregon do hereby make application for a certificate of registration as evidence of a right to appropriate ground water.

1. Source from which water is withdrawn is Pump Well #4 (Flowing well, pump well, infiltration trench, or tunnel)

2. Location is: 5 1/2 miles W Coburg (Approximate distance and direction from nearest city or town)

and is more particularly described as follows:

(a) 850' x 1970' W from S.E. Corner Sec. 11 (Give distance and bearing to corner of section or other legal subdivision)

being within SW 1/4 SE 1/4 of Sec. 11, Twp. 16S, Rge. 4W (Smallest legal subdivision) (N. or S.) (E. or W.)

or (b) within limits of recorded platted property, town or city:

in Lot \_\_\_\_\_ Block \_\_\_\_\_ of \_\_\_\_\_ (Name of plat or addition)

(If within city or town, give name) \_\_\_\_\_ County of \_\_\_\_\_

3. Construction Work was begun on 1942; was completed on 1942 (Date) (Date)

and the ground water claimed was first used for the purposes set out below on 1942 (Date)

since which time the water has been used \_\_\_\_\_ (Continuously or Intermittently)

from \_\_\_\_\_ to \_\_\_\_\_ (Date) (Date)

4. Quantity of water claimed and used is 250 gallons per minute; 51 acre feet per year.

5. Purpose or Purposes for which water is used Irrigation (Domestic, irrigation, municipal, manufacturing, industrial, etc.)

6. Description of Well: Depth 25 feet. Type Dug or drilled diameter 4 inches. Elevation of ground at well site 325 feet, mean sea level. (As near as known)

Depth to water table \_\_\_\_\_ feet.

7. Capacity of Well: \_\_\_\_\_ g.p.m. with \_\_\_\_\_ feet drawdown.

\_\_\_\_\_ g.p.m. with \_\_\_\_\_ feet drawdown.

Date of test \_\_\_\_\_

If Flowing Well: Measured discharge \_\_\_\_\_ g.p.m. on \_\_\_\_\_ (Date)

Shut-in pressure at ground surface \_\_\_\_\_ lbs. per sq. in. on \_\_\_\_\_ (Date)

Water is controlled by \_\_\_\_\_ (Ccp, valve, etc.)

8. Casing: (Give diameter, commercial specifications and depth below ground surface of each casing size.)

4 inch diameter ..... from 0 to 25 feet  
..... inch diameter ..... from ..... to ..... feet  
..... inch diameter ..... from ..... to ..... feet  
..... inch diameter ..... from ..... to ..... feet

Describe and show depth of shoe, plug, adapter, liner or other details: .....

9. Perforated Casings or Screens:

Casing was blown after being driven  
(Number per foot and size of perforations, or describe screen)

..... from ..... to .....  
..... from ..... to .....  
..... from ..... to .....

10. Log of Well: (Describe each stratum or formation clearly, indicate if water bearing, and give thickness and depth as indicated.)

MATERIAL	Thickness (Feet)	Depth to Bottom (Feet)
Sand & Gravel	25 ft	

If log of well is not available, give name and address of driller. ....

11. Infiltration Trench: Covered or open .....

Dimensions: Length ..... ft. Minimum depth ..... ft. Maximum depth ..... ft.

Bottom width ..... ft. Discharge ..... g.p.m. Date of test .....

12. Tunnel: Type of lining .....

Dimensions: .....  
(Length, course, and cross sectional size)

Position of water bearing stratum with reference to portal of tunnel .....

Log of tunnel: (Preceding table for log of well may be used, if desired. Give footage from portal and character of materials, as pertinent.)

13. Pumping Equipment:

(a) Pump Heairbanks motor Capacity 250 g.p.m.  
(Make, type and size)


(b) Motor 10-2  
(Type and horsepower)

14. Location of area irrigated or to be irrigated, or place of use if for purposes other than irrigation.

Township North or South	Range E. or W. of Willamette Meridian	Section	Forty-acre Tract	Number Acres To Be Irrigated	Date of Reclamation
16S	4W	11	SW 1/4 SE 1/4	17	1942

15. If the ground water supply is supplemental to an existing water supply, identification of any application for a permit, permit, certificate or adjudicated right to appropriate water made or held by the registrant.

Township 16S Range 4W, W.M.  
North

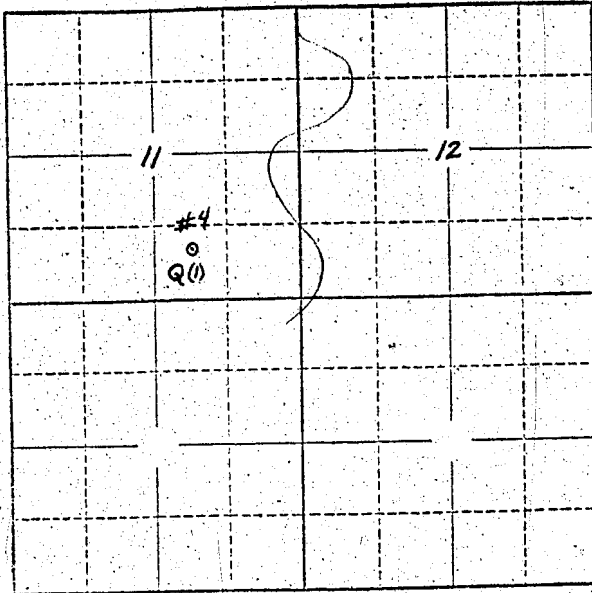

Locate well and acreage of irrigated land on plat.  
Scale: 2" = 1 Mile

STATE OF OREGON

County of ..... } ss.

I, ....., being first duly sworn, do hereby certify that I have read the foregoing Registration Statement and that all of the items therein contained are true to the best of my knowledge and belief.

.....  
(Signature of Registrant)

Subscribed and sworn to before me this ..... day of ....., 19.....

My commission expires .....  
(Notary Public)

(SEAL)

See Page GR-391 O for  
**CERTIFICATE OF REGISTRATION**

STATE OF OREGON

County of Marion } ss.

~~This is to certify that the foregoing Registration Statement was received in the office of the State Engineer on the ..... day of ..... 19..... and has been duly recorded in said office in Book No. .... of Registration Statements on page ..... Construction shall be completed by ..... and the water completely applied to beneficial use by ..... 19.....~~

Witness my hand this ..... day of ....., 19.....

.....  
(State Engineer)

By .....  
(Deputy)

Registration Statement CERTIFICATE NO. 391

OF CLAIMANT OF RIGHT TO APPROPRIATE GROUND WATER

(Under Chapter 703, Oregon Laws 1955.)

TO THE STATE ENGINEER OF OREGON:

I, W. J. Calvert

of Rt 2 Box 449 Eugene County of Lane

State of Oregon, do hereby make application for a certificate of registration as evidence of a right to appropriate ground water.

1. Source from which water is withdrawn is Pump Well #3  
(Flowing well, pump well, infiltration trench, or tunnel)

2. Location is: 5 1/4 miles N.W. of Coburg  
(Approximate distance and direction from nearest city or town)

and is more particularly described as follows:

(a) 550' N 89 1/2° W from S.E. Corner section 11  
(Give distance and bearing to corner of section or other legal subdivision)

being within SE 1/4 SE 1/4 of Sec. 11, Twp. 16 S, Rge. 4 W  
(Smallest legal subdivision) (N. or S.) (E. or W.)

or (b) within limits of recorded platted property, town or city:

in Lot \_\_\_\_\_, Block \_\_\_\_\_ of \_\_\_\_\_  
(Name of plat or addition)

County of \_\_\_\_\_  
(If within city or town, give name)

3. Construction Work was begun on 1947; was completed on 1947  
(Date) (Date)

and the ground water claimed was first used for the purposes set out below on 1947  
(Date)

since which time the water has been used \_\_\_\_\_  
(Continuously or Intermittently)

from \_\_\_\_\_ to \_\_\_\_\_  
(Date) (Date)

4. Quantity of water claimed and used is 250 gallons per minute; 100 acre feet per year.

5. Purpose or Purposes for which water is used irrigation

(Domestic, irrigation, municipal, manufacturing, industrial, etc.)

6. Description of Well: Depth 25 feet. Type Driven  
(Dug or drilled)

diameter 4 inches. Elevation of ground at well site 345' feet, mean sea level.  
(As near as known)

Depth to water table 20 feet.

7. Capacity of Well: \_\_\_\_\_ g.p.m. with \_\_\_\_\_ feet drawdown.

\_\_\_\_\_ g.p.m. with \_\_\_\_\_ feet drawdown.

Date of test \_\_\_\_\_

If Flowing Well: Measured discharge \_\_\_\_\_ g.p.m. on \_\_\_\_\_  
(Date)

Shut-in pressure at ground surface \_\_\_\_\_ lbs. per sq. in. on \_\_\_\_\_  
(Date)

Water is controlled by \_\_\_\_\_  
(Cap, valve, etc.)

8. **Casing:** (Give diameter, commercial specifications and depth below ground surface of each casing size.)

4 inch diameter ..... from : 0 ..... to 25 ..... feet  
 ..... inch diameter ..... from ..... to ..... feet  
 ..... inch diameter ..... from ..... to ..... feet  
 ..... inch diameter ..... from ..... to ..... feet

Describe and show depth of shoe, plug, adapter, liner or other details:

9. **Perforated Casings or Screens:**

Casing was blown after being driven ..... from ..... to .....  
(Number per foot and size of perforations, or describe screen)

..... from ..... to .....  
 ..... from ..... to .....  
 ..... from ..... to .....

10. **Log of Well:** (Describe each stratum or formation clearly, indicate if water bearing, and give thickness and depth as indicated.)

MATERIAL	Thickness (Feet)	Depth to Bottom (Feet)
Sands & Gravel	25ft	

If log of well is not available, give name and address of driller. ....

11. Infiltration Trench: Covered or open .....

Dimensions: Length ..... ft. Minimum depth ..... ft. Maximum depth ..... ft.

Bottom width ..... ft. Discharge ..... g.p.m. Date of test .....

12. Tunnel: Type of lining .....

Dimensions: .....  
(Length, course, and cross sectional size)

Position of water bearing stratum with reference to portal of tunnel' .....

Log of tunnel: (Preceding table for log of well may be used, if desired. Give footage from portal and character of materials, as pertinent.)

13. Pumping Equipment:

(a) Pump Fairbanks Morse Capacity 250 g.p.m.  
(Make, type and size)


(b) Motor 10-2  
(Type and horsepower)

14. Location of area irrigated or to be irrigated, or place of use if for purposes other than irrigation.

Township North or South	Range E. or W. of Willamette Meridian	Section	Forty-acre Tract	Number Acres To Be Irrigated	Date of Reclamation
16S	4W	11	SE 1/4 SE 1/4	32	1947
		14	NE 1/4 NE 1/4	3	"

15. If the ground water supply is supplemental to an existing water supply, identification of any application for a permit, permit, certificate or adjudicated right to appropriate water made or held by the registrant.

Township 16S Range 4W, W.M.  
North

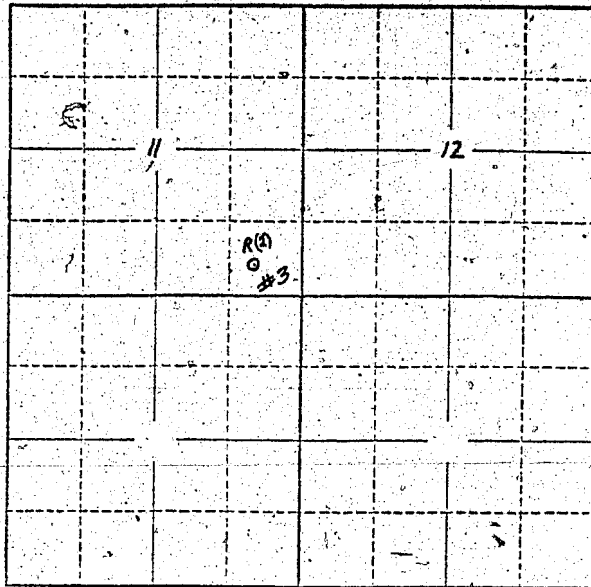

Locate well and acreage of irrigated land on plat.  
Scale: 2" = 1 Mile.

STATE OF OREGON

County of \_\_\_\_\_ } ss.

I, \_\_\_\_\_, being first duly sworn, do hereby certify that I have read the foregoing Registration Statement and that all of the items therein contained are true to the best of my knowledge and belief.

\_\_\_\_\_  
(Signature of Registrant)

Subscribed and sworn to before me this \_\_\_\_\_ day of \_\_\_\_\_, 19\_\_\_\_.

My commission expires \_\_\_\_\_  
(Notary Public)

(SEAL)

See Page GR-391 0 for  
**CERTIFICATE OF REGISTRATION**

STATE OF OREGON

County of Marion } ss.

~~This is to certify that the foregoing Registration Statement was received in the office of the State Engineer on the \_\_\_\_\_ day of \_\_\_\_\_, 19\_\_\_\_, and has been duly regarded in said office in Bank No. \_\_\_\_\_ of Registration Statements on page \_\_\_\_\_.~~

~~Construction shall be completed by \_\_\_\_\_, and the water completely applied to beneficial use by \_\_\_\_\_.~~

Witness my hand this \_\_\_\_\_ day of \_\_\_\_\_, 19\_\_\_\_.

\_\_\_\_\_  
(State Engineer)

By \_\_\_\_\_  
(Deputy)



# Registration Statement

## OF CLAIMANT OF RIGHT TO APPROPRIATE GROUND WATER

(Under Chapter 708, Oregon Laws 1955.)

TO THE STATE ENGINEER OF OREGON:

I, W. J. Calvert

Box 449 Eugene

County of Lane

State of Oregon do hereby make application for a certificate of registration as evidence of a right to appropriate ground water.

1. Source from which water is withdrawn is Pump Well #2  
(Flowing well, pump well, infiltration trench, or tunnel)

2. Location is: 5 1/4 miles N.W. of Eugene  
(Approximate distance and direction from nearest city or town)

and is more particularly described as follows:

(a) 518' x 82' W. from SE corner Sec. 11  
(Give distance and bearing to corner of section or other legal subdivision)

being within 56' x 56' 1/4 of Sec. 11, Twp. 16S, Rge. 4W  
(Smallest legal subdivision) (N. or S.) (E. or W.)

or (b) within limits of recorded platted property, town or city:

in Lot \_\_\_\_\_; Block \_\_\_\_\_ of \_\_\_\_\_  
(Name of plat or addition)

County of \_\_\_\_\_  
(If within city or town, give name)

3. Construction Work was begun on 1936; was completed on 1936  
(Date) (Date)

and the ground water claimed was first used for the purposes set out below on 1936  
(Date)

since which time the water has been used \_\_\_\_\_  
(Continuously or intermittently)

from \_\_\_\_\_ to \_\_\_\_\_  
(Date) (Date)

4. Quantity of water claimed and used is 250 gallons per minute; 75 acre feet per year.

5. Purpose or Purposes for which water is used Irrigation

(Domestic, irrigation, municipal, manufacturing, industrial, etc.)

6. Description of Well: Depth 25 feet. Type Driven

diameter 4 inches. Elevation of ground at well site 345 feet, mean sea level.  
(As near as known) (Dug or drilled)

Depth to water table 20 feet.

7. Capacity of Well: \_\_\_\_\_ g.p.m. with \_\_\_\_\_ feet drawdown.

\_\_\_\_\_ g.p.m. with \_\_\_\_\_ feet drawdown.

Date of test \_\_\_\_\_

If Flowing Well: Measured discharge \_\_\_\_\_ g.p.m. on \_\_\_\_\_  
(Date)

Shut-in pressure at ground surface \_\_\_\_\_ lbs. per sq. in. on \_\_\_\_\_  
(Date)

Water is controlled by \_\_\_\_\_  
(Cap, valve, etc.)

8. Casing: (Give diameter, commercial specifications and depth below ground surface of each casing size.)

4 inch diameter from 0 to 25 feet  
 inch diameter from to feet  
 inch diameter from to feet  
 inch diameter from to feet

Describe and show depth of shoe, plug, adapter, liner or other details: \_\_\_\_\_  
 \_\_\_\_\_  
 \_\_\_\_\_

9. Perforated Casings or Screens:

Casing was blown after being driven.  
(Number per foot and size of perforations, or describe screen)  
 from to  
 from to  
 from to

10. Log of Well: (Describe each stratum or formation clearly, indicate if water bearing, and give thickness and depth as indicated.)

MATERIAL	Thickness (Feet)	Depth to Bottom (Feet)
Sand & Gravel	25 ft	

If log of well is not available, give name and address of driller.

11. Infiltration Trench: Covered or open

Dimensions: Length ..... ft. Minimum depth ..... ft. Maximum depth ..... ft.  
Bottom width ..... ft. Discharge ..... g.p.m. Date of test .....

12. Tunnel: Type of lining

Dimensions: ..... (Length, course, and cross sectional size)

Position of water bearing stratum with reference to portal of tunnel .....

Log of tunnel: (Preceding table for log of well may be used, if desired. Give footage from portal and character of materials, as pertinent.)

13. Pumping Equipment:

(a) Pump *airbanks motor* Capacity *250* g.p.m.  
(Make, type and size)


(b) Motor *10-2*  
(Type and horsepower)

14. Location of area irrigated or to be irrigated, or place of use if for purposes other than irrigation.

Township North or South	Range E. or W. of Willamette Meridian	Section	Forty-acre Tract	Number Acres To Be Irrigated	Date of Reclamation
<i>16S</i>	<i>4W</i>	<i>11</i>	<i>SE 1/4 SE 1/4</i>	<i>11</i>	<i>1936</i>
		<i>12</i>	<i>SW 1/4 SW 1/4</i>	<i>11</i>	"
		<i>13</i>	<i>NW 1/4 NW 1/4</i>	<i>1 1/2</i>	"
		<i>14</i>	<i>NE 1/4 NE 1/4</i>	<i>1 1/2</i>	"
				<i>25</i>	

15. If the ground water supply is supplemental to an existing water supply, identification of any application for a permit, permit, certificate or adjudicated right to appropriate water made or held by the registrant.

Township 165 Range 40, W.M.  
North

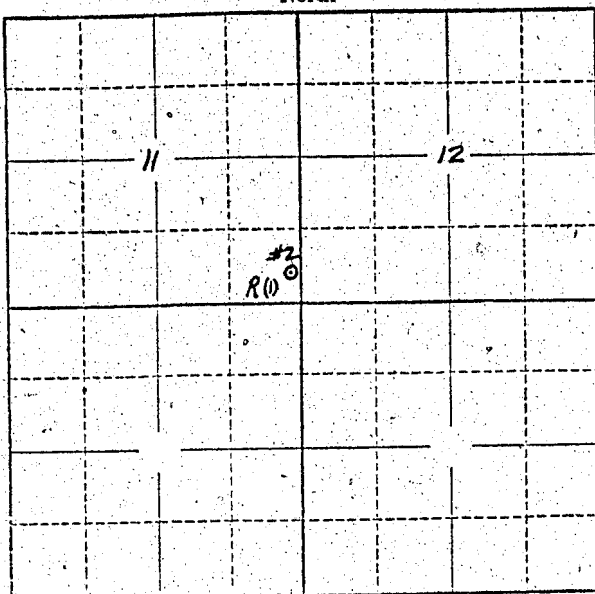

Locate well and acreage of irrigated land on plat.

Scale: 2" = 1 Mile

STATE OF OREGON

County of .....

} ss.

I, ....., being first duly sworn, do hereby certify that I have read the foregoing Registration Statement and that all of the items therein contained are true to the best of my knowledge and belief.

.....  
(Signature of Registrant)

Subscribed and sworn to before me this ..... day of ....., 19.....

My commission expires .....

.....  
(Notary Public)

(SEAL)

See Page GR-391 O for  
**CERTIFICATE OF REGISTRATION**

STATE OF OREGON

County of Marion

} ss.

~~This is to certify that the foregoing Registration Statement was received in the office of the State Engineer on the X-X-X-X day of X-X-X-X-X-X-X-X 19-X-X-X-X-X-X-X-X at X-X-X-X and has been duly recorded in said office in Book No. X-X-X-X-X-X of Registration Statements on page X-X-X-X-X-X.~~

~~Construction shall be completed by X-X-X-X-X-X-X-X, 19X-X, and the water completely applied to beneficial use by X-X-X-X-X-X-X-X, 19X-X.~~

Witness my hand this ..... day of ....., 19.....

.....  
(State Engineer)

By .....

.....  
(Deputy)

# Registration Statement

## OF CLAIMANT OF RIGHT TO APPROPRIATE GROUND WATER

(Under Chapter 708, Oregon Laws 1955.)

TO THE STATE ENGINEER OF OREGON:

I, D.J. Calvert

P.O. Box 449 Eugene County of Lane

State of Oregon, do hereby make application for a certificate of registration as evidence of a right to appropriate ground water.

1. Source from which water is withdrawn is Pump Well #1  
(Flowing well, pump well, infiltration trench, or tunnel)

2. Location is: 5 1/4 miles NW Coburg  
(Approximate distance and direction from nearest city or town)

and is more particularly described as follows:

(a) 1693' N + 117' W from S.E. Corner of Sec. 11  
(Give distance and bearing to corner of section or other legal subdivision)

being within N 1/4 SE 1/4 of Sec. 11 Twp. 16 S Rge. 4 W  
(Smallest legal subdivision) (N. or S.) (E. or W.)

or (b) within limits of recorded platted property, town or city:

in Lot \_\_\_\_\_, Block \_\_\_\_\_ of \_\_\_\_\_  
(Name of plat or addition)

County of \_\_\_\_\_  
(If within city or town, give name)

3. Construction Work was begun on 1942; was completed on 1942  
(Date) (Date)

and the ground water claimed was first used for the purposes set out below on 1942  
(Date)

since which time the water has been used Continuously during season  
(Continuously or intermittently)

from 1942 to Mar. 1957  
(Date) (Date)

4. Quantity of water claimed and used is 950 gallons per minute; 51 acre feet per year.

5. Purpose or Purposes for which water is used irrigation

(Domestic, irrigation, municipal, manufacturing, industrial, etc.)

6. Description of Well: Depth 25 feet. Type Driven  
(Dug or drilled)

diameter 4 inches. Elevation of ground at well site 345 feet, mean sea level.  
(As near as known)

Depth to water table 30 feet.

7. Capacity of Well: \_\_\_\_\_ g.p.m. with \_\_\_\_\_ feet drawdown.

\_\_\_\_\_ g.p.m. with \_\_\_\_\_ feet drawdown.

Date of test \_\_\_\_\_

If Flowing Well: Measured discharge \_\_\_\_\_ g.p.m. on \_\_\_\_\_  
(Date)

Shut-in pressure at ground surface \_\_\_\_\_ lbs. per sq. in. on \_\_\_\_\_  
(Date)

Water is controlled by \_\_\_\_\_  
(Cap, valve, etc.)

8. Casing: (Give diameter, commercial specifications and depth below ground surface of each casing size.)

4 inch diameter ..... from 0 to 25 feet  
 ..... inch diameter ..... from ..... to ..... feet  
 ..... inch diameter ..... from ..... to ..... feet  
 ..... inch diameter ..... from ..... to ..... feet

Describe and show depth of shoe, plug, adapter, liner or other details: .....

9. Perforated Casings or Screens:

Casing was blown after being driven from ..... to .....  
(Number per foot and size of perforations, or describe screen)  
 ..... from ..... to .....  
 ..... from ..... to .....  
 ..... from ..... to .....

10. Log of Well: (Describe each stratum or formation clearly, indicate if water bearing, and give thickness and depth as indicated.)

MATERIAL	Thickness (Feet)	Depth to Bottom (Feet)
Sand & Gravel	25 ft	

If log of well is not available, give name and address of driller. ....

**11. Infiltration Trench: Covered or open** .....

Dimensions: Length ..... ft. Minimum depth ..... ft. Maximum depth ..... ft.

Bottom width ..... ft. Discharge ..... g.p.m. Date of test .....

**12. Tunnel: Type of lining** .....

Dimensions: .....  
(Length, course, and cross sectional size) .....

Position of water bearing stratum with reference to portal of tunnel .....

Log of tunnel: (Preceding table for log of well may be used, if desired. Give footage from portal and character of materials, as pertinent.)

**13. Pumping Equipment:**

(a) Pump Freibach Motor Capacity 250 g.p.m.  
(Make, type and size)


(b) Motor 10-2  
(Type and horsepower)

**14. Location of area irrigated or to be irrigated, or place of use if for purposes other than irrigation.**

Township North or South	Range E. or W. of Willamette Meridian	Section	Forty-acre Tract	Number Acres To Be Irrigated	Date of Reclamation
16S	4W.	11	NE 1/4 SE 1/4	18	1942

15. If the ground water supply is supplemental to an existing water supply, identification of any application for a permit, permit, certificate or adjudicated right to appropriate water made or held by the registrant.

Township 16 S Range 4 W, W.M. North

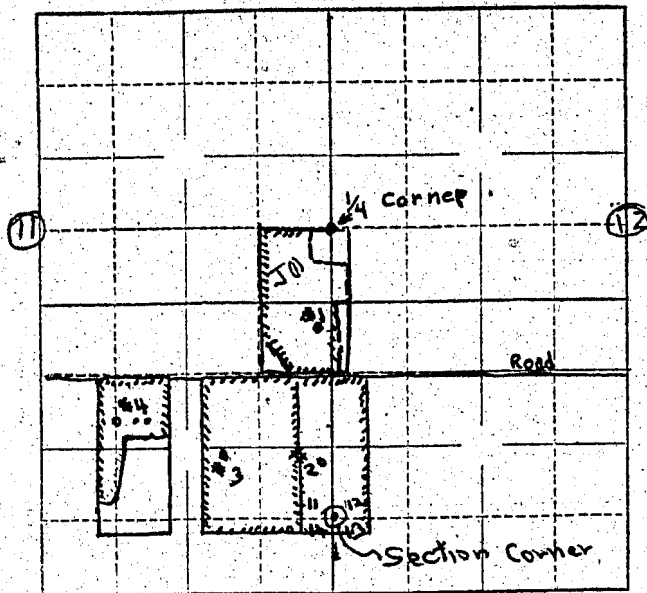

Locate well and acreage of irrigated land on plat.

Scale: X = 1 Mile  
1/4 = 1 mile

STATE OF OREGON

County of \_\_\_\_\_

ss.

I, H. J. Calvert, being first duly sworn, do hereby certify that I have read the foregoing Registration Statement and that all of the items therein contained are true to the best of my knowledge and belief.

H. J. Calvert  
(Signature of Registrant)

Subscribed and sworn to before me this 20 day of March, 1957.

My commission expires Sept. 2, 1960

Chas. [Signature]  
(Notary Public)

(SEAL)

CERTIFICATE OF REGISTRATION

STATE OF OREGON

County of Marion

ss.

This is to certify that the foregoing Registration Statement was received in the office of the State Engineer on the 20th day of March, 1957, at 4:00 o'clock P.M. and has been duly recorded in said office in Book No. 3 of Registration Statements on page GR-391 0.

~~Construction shall be completed by X-X-X-X-X-X-X-X-X-X-19-X-X and the water completely applied to beneficial use by X-X-X-X-X-X-X-X-X-X-19-X-X~~

Witness my hand this 23rd day of May, 1957

Lewis A. Stanley  
(State Engineer)

By \_\_\_\_\_ (Deputy)