

Registration Statement

OF CLAIMANT OF RIGHT TO APPROPRIATE GROUND WATER

TO THE STATE ENGINEER OF OREGON:

I, Walter H. Lose,

of 230 Superior St. S. (Salem) County of Marion

State of Oregon do hereby make application for a certificate of registration as evidence of a right to appropriate ground water.

1. Source from which water is withdrawn by Pump well
(Flowing well, pump well, infiltration trench, or tunnel)

2. Location is: 3 1/2 mi. South of Salem on Liberty Rd. (4910)
(Approximate distance and direction from nearest city or town)

and is more particularly described as follows: 450 feet West & 900 feet North from S 1/4 corner

(a) adjacent Liberty School grounds - South West
(Give distance and bearing to corner of section or other legal subdivision)

being within SE 1/4 SW 1/4 of Sec. 09, Twp. 05, Rge. 37
(Smallest legal subdivision) (N. or S.) (E. or W.)

or (b) within limits of recorded platted property, town or city:

in Lot _____, Block _____ of _____
(Name of plat or addition)

County of _____
(If within city or town, give name)

3. Construction Work was begun on 1950; was completed on 1950
(Date) (Date)

and the ground water claimed was first used for the purposes set out below on Apr 1950
(Date)

since which time the water has been used continuously
(Continuously or intermittently)

from Apr 1950 to present time
(Date) (Date)

4. Quantity of water claimed and used is 50 gallons per minute; _____ acre feet per year.

5. Purpose or Purposes for which water is used Domestic Farm use and irrigation
(Domestic, irrigation, municipal, manufacturing, industrial, etc.)

6. Description of Well: Depth 150 feet. Type drilled
(Dug or drilled)

diameter 10 inches. Elevation of ground at well site 180 (approx) feet, mean sea level.
(As near as known)

Depth to water table 40 feet.

7. Capacity of Well: 50 g.p.m. with 50 feet drawdown.

_____ g.p.m. with _____ feet drawdown.

Date of test 1953

If Flowing Well: Measured discharge _____ g.p.m. on _____
(Date)

Shut-in pressure at ground surface _____ lbs. per sq. in. on _____
(Date)

Water is controlled by _____
(Cap, valve, etc.)

8. Casing: (Give diameter, commercial specifications and depth below ground surface of each casing size.)

1.0 inch diameter *Steel casing* from 0 to 150 feet
 _____ inch diameter _____ from _____ to _____ feet
 _____ inch diameter _____ from _____ to _____ feet
 _____ inch diameter _____ from _____ to _____ feet

Describe and show depth of shoe, plug, adapter, liner or other details: _____


9. Perforated Casings or Screens:

yes Mills Knife every 3 feet from 50 to 150
 (Number per foot and size of perforations, or describe screen)
 _____ from _____ to _____
 _____ from _____ to _____
 _____ from _____ to _____

10. Log of Well: (Describe each stratum or formation clearly, indicate if water bearing, and give thickness and depth as indicated.)

MATERIAL	Thickness (Feet)	Depth to Bottom (Feet)
<i>No Log available - 30' or more well was drilled through and no log</i>		

Township 85 Range 3W W.M.
North

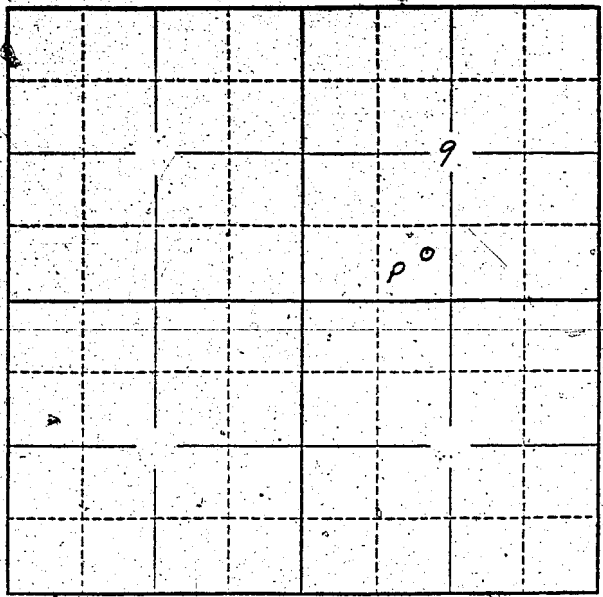

Locate well and acreage of irrigated land on plat.
Scale: 2" = 1 Mile

STATE OF OREGON

County of Marion } ss.

I, Walter H. Zosel, being first duly sworn, do hereby certify that I have read the foregoing Registration Statement and that all of the items therein contained are true to the best of my knowledge and belief.

Walter H. Zosel
(Signature of Registrant)

Subscribed and sworn to before me this 4th day of August, 1958.

My commission expires 4-20-59

Hein E. Stevens
(Notary Public)

Notary for Oregon.

(SEAL)

CERTIFICATE OF REGISTRATION

STATE OF OREGON

County of Marion } ss.

This is to certify that the foregoing Registration Statement was received in the office of the State Engineer on the 4th day of August, 1958, at 3:00 o'clock P. M. and has been duly recorded in said office in Book No. 15 of Registration Statements on page GR-3676

Witness my hand this 20th day of October, 1959.

Lewis A. Stanley
(State Engineer)

By _____ (Deputy)

\$15.00

GR 3676