

# Registration Statement

## OF CLAIMANT OF RIGHT TO APPROPRIATE GROUND WATER

TO THE STATE ENGINEER OF OREGON:

I, Ronald E. Jones  
 of P. O. Box 98 Brooks County of Marion  
(Mailing address)  
 State of Oregon, do hereby make application for a certificate of registration as evidence of a right to appropriate ground water.

1. Source from which water is withdrawn is Pump Well #2  
(Flowing well, pump well, infiltration trench, or tunnel)
2. Location is: 2 1/2 miles S E of Brooks  
(Approximate distance and direction from nearest city or town)

and is more particularly described as follows:

(a) 11 82 Ch. S & 37 65 Ch. E from the NE corner of section 28  
(Give distance and bearing to corner of section or other legal subdivision)  
 being within NW 1/4 NE 1/4 of Sec. 28, Twp. 6 S, Rge. 2 W  
(Smallest legal subdivision) (N. or S.) (E. or W.)

or (b) within limits of recorded platted property, town or city:

in Lot \_\_\_\_\_ Block \_\_\_\_\_ of \_\_\_\_\_  
(Name of plat or addition)  
 County of Marion  
(If within city or town, give name)

3. Construction Work was begun on April 48; was completed on April 48  
(Date) (Date)  
 and the ground water claimed was first used for the purposes set out below on April 19 48  
(Date)  
 since which time the water has been used Intermittently  
(Continuously or Intermittently)  
 from 48 to Aug 56  
(Date) (Date)

4. Quantity of water claimed and used is ~~2000~~ 25 gallons per minute; \_\_\_\_\_ acre feet per year.

5. Purpose or Purposes for which water is used Irrigation

(Domestic, irrigation, municipal, manufacturing, industrial, etc.)  
 6. Description of Well: Depth 55 feet. Type Drilled  
(Dug or drilled)  
 diameter 6 inches. Elevation of ground at well site 190 feet, mean sea level.  
(As near as known)  
 Depth to water table 3" feet.

7. Capacity of Well: 300 g.p.m. with 15 feet drawdown.  
 \_\_\_\_\_ g.p.m. with \_\_\_\_\_ feet drawdown.

Date of test \_\_\_\_\_

If Flowing Well: Measured discharge \_\_\_\_\_ g.p.m. on \_\_\_\_\_  
(Date)


Shut-in pressure at ground surface \_\_\_\_\_ lbs. per sq. in. on \_\_\_\_\_  
(Date)

Water is controlled by \_\_\_\_\_  
(Cap, valve, etc.)





Township 6S Range 2W W.M. North

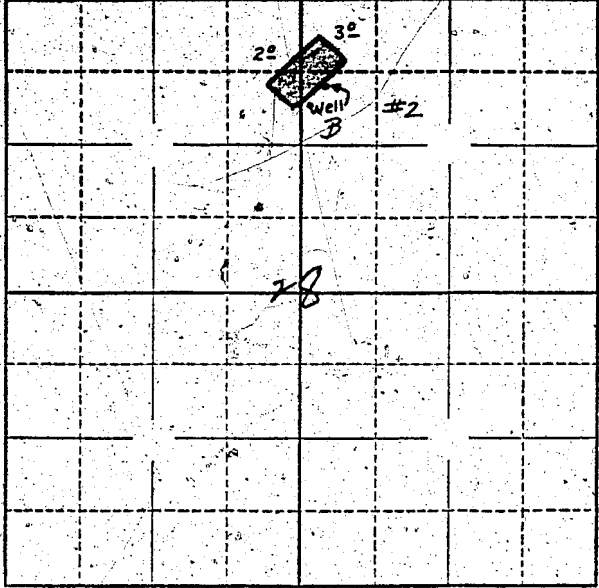

Locate well and acreage of irrigated land on plat.  
Scale: 1/4 - 1 Mile

STATE OF OREGON  
County of Marion } ss.

I, Ronald Jones, being first duly sworn, do hereby certify that I have read the foregoing Registration Statement and that all of the items therein contained are true to the best of my knowledge and belief.

Ronald Jones  
(Signature of Registrant)

Subscribed and sworn to before me this 4th day of August, 1958.

My commission expires 12th June 1961 Wm. S. Bartholomew  
(Notary Public)

(SEAL)

**CERTIFICATE OF REGISTRATION**

STATE OF OREGON }  
County of Marion } ss.

This is to certify that the foregoing Registration Statement was received in the office of the State Engineer on the 4th day of August, 1958, at 3:10 o'clock P. M. and has been duly recorded in said office in Book No. 15 of Registration Statements on page GR-3678

Witness my hand this 20th day of October, 1959

Laura A. Stanley  
(State Engineer)

\$15.00

By \_\_\_\_\_ (Deputy)

GR. 3678