

Registration No. GR - 4085

Certificate No. GR - 3966

Registration Statement

OF CLAIMANT OF RIGHT TO APPROPRIATE GROUND WATER

TO THE STATE ENGINEER OF OREGON:

I, Ray C Hagensauer

of Rt 1 Box 12 Woodburn County of Marion

State of Oregon, do hereby make application for a certificate of registration as evidence of a right to appropriate ground water.

1. Source from which water is withdrawn is pump well
(Flowing well, pump well, infiltration trench, or tunnel)

2. Location is: 3/4 mi North of Woodburn
(Approximate distance and direction from nearest city or town)

and is more particularly described as follows:

(a) S 41° 0' E 1910' from NW Cor Sec 8 T5s R2W
(Give distance and bearing to corner of section or other legal subdivision)

being within SW 1/4 of the NW 1/4 of Sec. 8, Twp. 5 S, Rge. 2 W
(Smallest legal subdivision) (N. or S.) (E. or W.)

or (b) within limits of recorded platted property, town or city:

in Lot _____, Block _____ of _____
(Name of plat or addition)

County of _____
(If within city or town, give name)

3. Construction Work was begun on Jan 1955; was completed on Feb 1955
(Date) (Date)

and the ground water claimed was first used for the purposes set out below on June 1956
(Date)

since which time the water has been used Continuously
(Continuously or intermittently)

from June 1956 to _____ date _____
(Date) (Date)

4. Quantity of water claimed and used is 60 gallons per minute; _____ acre feet per year.

5. Purpose or Purposes for which water is used irrigation (exempt)
(Domestic, irrigation, municipal, manufacturing, industrial, etc.)

6. Description of Well: Depth 155 feet. Type drilled
(Dug or drilled)

diameter 6 inches. Elevation of ground at well site 175 feet, mean sea level.
(As near as known)

Depth to water table 27 feet.

7. Capacity of Well: 60 g.p.m. with 60 feet drawdown.

_____ g.p.m. with _____ feet drawdown.

Date of test _____

If Flowing Well: Measured discharge _____ g.p.m. on _____
(Date)

Shut-in pressure at ground surface _____ lbs. per sq. in. on _____
(Date)

Water is controlled by _____
(Cap, valve, etc.)

8. **Casing:** (Give diameter, commercial specifications and depth below ground surface of each casing size.)

6 inch diameter steel casing from 0 to 135 feet

inch diameter from to feet

inch diameter from to feet

inch diameter from to feet

Describe and show depth of shoe, plug, adapter, liner or other details: _____

9. **Perforated Casings or Screens:**

1/2 " x 2" perforations 8 per row - rows 1' apart from 125 to 135

(Number per foot and size of perforations, or describe screen)

from to

from to

from to

10. **Log of Well:** (Describe each stratum or formation clearly, indicate if water bearing, and give thickness and depth as indicated.)

MATERIAL	Thickness (Feet)	Depth to Bottom (Feet)

If log of well is not available, give name and address of driller: No Log kept - Well drilled by form

owner

11. Infiltration Trench: Covered or open

Dimensions: Length ft. Minimum depth ft. Maximum depth ft.

Bottom width ft. Discharge g.p.m. Date of test

12. Tunnel: Type of lining

Dimensions:
(Length, course, and cross sectional size)

Position of water bearing stratum with reference to portal of tunnel

Log of tunnel: (Preceding table for log of well may be used, if desired. Give footage from portal and character of materials, as pertinent.)

13. Pumping Equipment:

(a) Pump 1 1/2" Jet Capacity g.p.m.
(Make, type and size)


(b) Motor 3 hp single phase
(Type and horsepower)

14. Location of area irrigated or to be irrigated, or place of use if for purposes other than irrigation.

Township North or South	Range E. or W. of Willamette Meridian	Section	Forty-acre Tract	Number Acres To Be Irrigated	Date of Reclamation
5 S	2 W	8	SW 1/4 of the NW 1/4	20	June 1956
5 S	2 W	8	NE 1/4 of the NW 1/4	10	June 1956
5 S	2 W	8	SE 1/4 of the NW 1/4	10	June 1956
				<u>13.0</u>	

15. If the ground water supply is supplemental to an existing water supply, identification of any application for a permit, permit, certificate or adjudicated right to appropriate water made or held by the registrant.

Township 5S Range 2W, W.M.
North

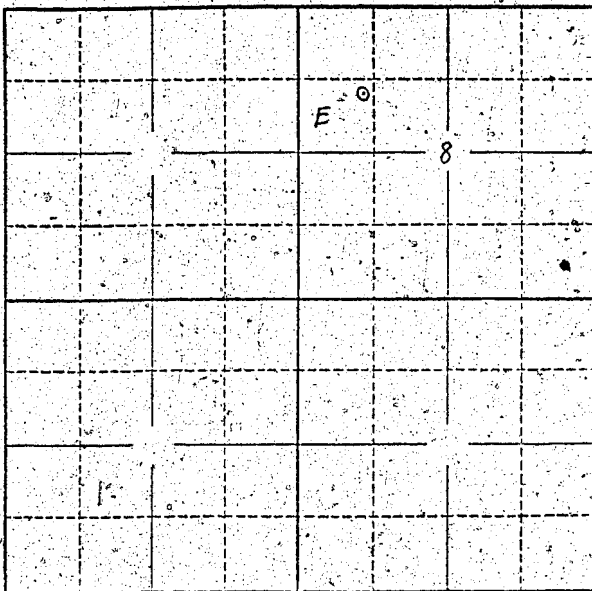

Locate well and acreage of irrigated land on plat.
Scale: 2" = 1 Mile

STATE OF OREGON

County of MARION } ss.

I, Ray C. Hagenauer, being first duly sworn, do hereby certify that I have read the foregoing Registration Statement and that all of the items therein contained are true to the best of my knowledge and belief.

Ray C. Hagenauer
(Signature of Registrant)

Subscribed and sworn to before me this 31st day of July, 1958

My commission expires 8-22-58
H.B. Madamida
(Notary Public for Oregon)

(SEAL)

CERTIFICATE OF REGISTRATION

STATE OF OREGON

County of Marion } ss.

This is to certify that the foregoing Registration Statement was received in the office of the State Engineer on the 4 day of August, 1958, at 8:00 o'clock A.M. and has been duly recorded in said office in Book No. 16 of Registration Statements on page 62-3966

Witness my hand this 15th day of February, 1960

15.00

Laura A. Stanley
(State Engineer)

By _____ (Deputy)