

RECEIVED  
AUG 4 1958

STATE ENGINEER  
SALEM, OREGON

Registration No. GR-4088

Certificate No. GR-3681

### Registration Statement

#### OF CLAIMANT OF RIGHT TO APPROPRIATE GROUND WATER

TO THE STATE ENGINEER OF OREGON:

I, Raymond L Frost & Luella R Frost  
of Rainbow Ranch Selma, Ore County of Josephine  
State of Oregon do hereby make application for a certificate of registration as evidence  
of a right to appropriate ground water.

1. Source from which water is withdrawn is pump well  
(Flowing well, pump well, infiltration trench, or tunnel)

2. Location is: 2 mi E of Selma Oregon  
(Approximate distance and direction from nearest city or town)

and is more particularly described as follows:

(a) 40 ft S & 1525 ft E of NW Cor Sec 13  
(Give distance and bearing to corner of section or other legal subdivision)  
being within NE 1/4 NW 1/4 of Sec. 13, Twp. 37S, Rge. 7 W W 11  
(Smallest legal subdivision) (S. or S.) (E. or W.)

or (b) within limits of recorded platted property, town or city:

in Lot \_\_\_\_\_, Block \_\_\_\_\_ of \_\_\_\_\_  
(Name of plat or addition)  
County of \_\_\_\_\_  
(If within city or town, give name)

3. Construction Work was begun on Sept 1949; was completed on Oct 1949  
(Date) (Date)

and the ground water claimed was first used for the purposes set out below on May 1950  
(Date)

since which time the water has been used continuously  
(Continuously or intermittently)

from May 1950 to present (7-28-58)  
(Date) (Date)

4. Quantity of water claimed and used is 150 gallons per minute; 20 acre  
feet per year.

5. Purpose or Purposes for which water is used irrigation

(Domestic, irrigation, municipal, manufacturing, industrial, etc.)

6. Description of Well: Depth 22 feet. Type drilled  
(Dug or drilled)

diameter 8 inches. Elevation of ground at well site 1030 feet, mean sea level.  
(As near as known)

Depth to water table 14 feet.

7. Capacity of Well: 150 g.p.m. with 7 feet drawdown.

\_\_\_\_\_ g.p.m. with \_\_\_\_\_ feet drawdown.

Date of test 1953

If Flowing Well: Measured discharge 100's net 4750 g.p.m. on \_\_\_\_\_  
(Date)

Shut-in pressure at ground surface \_\_\_\_\_ lbs. per sq. in. on \_\_\_\_\_  
(Date)

Water is controlled by \_\_\_\_\_  
(Cap, valve, etc.)

8. Casing: (Give diameter, commercial specifications and depth below ground surface of each casing size.)

8 inch diameter ..... from 0 to 22 feet  
 ..... inch diameter ..... from ..... to ..... feet  
 ..... inch diameter ..... from ..... to ..... feet  
 ..... inch diameter ..... from ..... to ..... feet

Describe and show depth of shoe, plug, adapter, liner or other details: none

9. Perforated Casings or Screens:

12- 1/4 x 3 ..... from 14 to 22'  
 (Number per foot and size of perforations, or describe screen)  
 ..... from ..... to .....  
 ..... from ..... to .....  
 ..... from ..... to .....

10. Log of Well: (Describe each stratum or formation clearly, indicate if water bearing, and give thickness and depth as indicated.)

MATERIAL	Thickness (Feet)	Depth to Bottom (Feet)
gravelly loam	3	3
gravel - fins in voids - water bearing strata" intermittent intervals	19	22

If log of well is not available, give name and address of driller.

11. Infiltration Trench: Covered or open *does not apply*

Dimensions: Length \_\_\_\_\_ ft. Minimum depth \_\_\_\_\_ ft. Maximum depth \_\_\_\_\_ ft.

Bottom width \_\_\_\_\_ ft. Discharge \_\_\_\_\_ g.p.m. Date of test \_\_\_\_\_

12. Tunnel: Type of lining *does not apply*

Dimensions: \_\_\_\_\_  
(Length, course, and cross sectional size)

Position of water bearing stratum with reference to portal of tunnel \_\_\_\_\_

Log of tunnel: (Preceding table for log of well may be used, if desired. Give footage from portal and character of materials, as pertinent.)

13. Pumping Equipment:

(a) Pump *2" centrifugal* Capacity *200* g.p.m. *W. G. W.*  
(Make, type and size)


(b) Motor *1.0 hp electric motor*  
(Type and horsepower)

14. Location of area irrigated or to be irrigated, or place of use if for purposes other than irrigation.

Township North or South	Range E. or W. of Willamette Meridian	Section	Forty-acre Tract	Number Acres To Be Irrigated	Date of Reclamation
37 S	7 W	13	NW 1/4 NW 1/4	10	1950
37 S	7 W	13	NE 1/4 NW 1/4	2	1950
				<u>12</u>	

15. If the ground water supply is supplemental to an existing water supply, identification of any application for a permit, permit, certificate or adjudicated right to appropriate water made or held by the registrant.  
*48 acre Mc. Mullon Cr. Right*

Township 37S Range 7W, W.M.

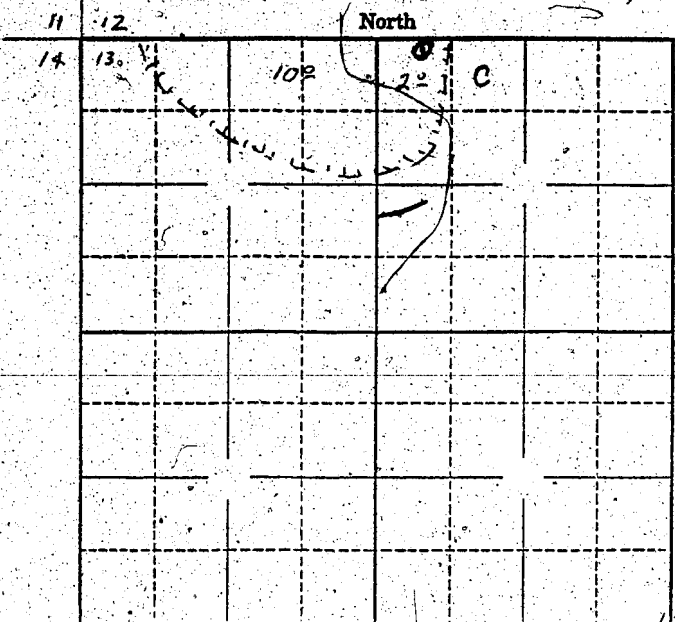

Locate well and acreage of irrigated land on plat.  
Scale:  $\frac{1}{2}$  - 1 Mile

STATE OF OREGON

County of Josephine } ss.  
Raymond L. Frost and  
Robetta R. Frost

I, Raymond L. Frost, being first duly sworn, do hereby certify that I have read the foregoing Registration Statement and that all of the items therein contained are true to the best of my knowledge and belief.

Raymond L. Frost  
(Signature of Registrant)

Subscribed and sworn to before me this 31st day of July, 1958

My commission expires Dec 18th 1960 Stella M. Stengel  
(Notary Public)

(SEAL)

**CERTIFICATE OF REGISTRATION**

STATE OF OREGON } ss.  
County of Marion

This is to certify that the foregoing Registration Statement was received in the office of the State Engineer on the 4th day of August, 1958, at 2.00 o'clock A. M. and has been duly recorded in said office in Book No. 15 of Registration Statements on page OR 3681

Witness my hand this 20th day of October, 1959

Luvo A. Stanley  
(State Engineer)

By \_\_\_\_\_  
(Deputy)

\$15.00

GR 3681