

Registration Statement

OF CLAIMANT OF RIGHT TO APPROPRIATE GROUND WATER

TO THE STATE ENGINEER OF OREGON:

I, Raymond L Frost & Loretta R Frost
of Rainbow Ranch, Milwau, Ore County of Josephine
State of Oregon, do hereby make application for a certificate of registration as evidence
of a right to appropriate ground water.

1. Source from which water is withdrawn is Sump
(Flowing well, pump well, infiltration trench, or tunnel)
2. Location is: 5 mi E of Sebec, Oregon
(Approximate distance and direction from nearest city or town)

and is more particularly described as follows:

- (a) 590 ft north & 810 ft west of SE Cor Sec 9
(Give distance and bearing to corner of section or other legal subdivision)
 - (b) within limits of recorded platted property, town or city:
- being within SE 1/4 SE 1/4 of Sec. 9, Twp. 38 S, Rge. 7 W
(Smallest legal subdivision) (T. or S.) (E. or W.)
- in Lot _____, Block _____ of _____
(Name of plat or addition)

(If within city or town, give name)

3. Construction Work was begun on June 1948; was completed on June 1948
(Date) (Date)

and the ground water claimed was first used for the purposes set out below on July 1948
(Date)
since which time the water has been used continuously
(Continuously or intermittently)
from July 1948 to present
(Date) (Date)

4. Quantity of water claimed and used is 1500 gallons per minute; 100 acre feet per year.
5. Purpose or Purposes for which water is used irrigation

(Domestic, irrigation, municipal, manufacturing, industrial, etc.)

6. Description of Well: Depth 14 feet. Type Sump
(Dug or drilled)
diameter _____ inches. Elevation of ground at well site 1080 feet, mean sea level.
(As near as known)
Depth to water table 5-10 feet. according to time of year

7. Capacity of Well: 1500 g.p.m. with 8 feet drawdown.
_____ g.p.m. with _____ feet drawdown.

Date of test 1952

If Flowing Well: Measured discharge _____ g.p.m. on _____
(Date)

Shut-in pressure at ground surface _____ lbs. per sq. in. on _____
(Date)

Water is controlled by _____
(Cap, valve, etc.)

8. Casing: (Give diameter, commercial specifications and depth below ground surface of each casing size.)

does not apply

..... inch diameter from to feet

..... inch diameter from to feet

..... inch diameter from to feet

..... inch diameter from to feet

Describe and show depth of shoe, plug, adapter, liner or other details: *does not apply*

9. Perforated Casings or Screens:

does not apply

*(Number per foot and size of perforations, or describe screen)

from to

from to

from to

from to

10. Log of Well: (Describe each stratum or formation clearly, indicate if water bearing, and give thickness and depth as indicated.)

MATERIAL	Thickness (Feet)	Depth to Bottom (Feet)
<i>Sandy loam</i>	<i>4</i>	<i>8 2</i>
<i>gravel & fines - varying permeability</i>	<i>10</i>	<i>14</i>

If log of well is not available, give name and address of driller.

11. Infiltration Trench: Covered or open Open

Dimensions: Length 7.5 ft. Minimum depth 1.2 ft. Maximum depth 1.4 ft.

Bottom width 2.0 ft. Discharge 500-1500 g.p.m. Date of test

12. Tunnel: Type of lining no app

Dimensions:
(Length, course, and cross sectional size)

Position of water bearing stratum with reference to portal of tunnel

Log of tunnel: (Preceding table for log of well may be used, if desired. Give footage from portal and character of materials, as pertinent.)

13. Pumping Equipment:

(a) Pump 6" Berkley centrifugal Capacity 1500 g.p.m.
(Make, type and size)

(b) Motor 15 hp electric motor
(Type and horsepower)


14. Location of area irrigated or to be irrigated, or place of use if for purposes other than irrigation.

Township North or South	Range E. or W. of Willamette Meridian	Section	Forty-acre Tract	Number Acres To Be Irrigated	Date of Reclamation
37.5	7W	9	SE 1/4 SE 1/4	9.0	1948
37.5	7W	9	SW 1/4 SE 1/4	30.0	1948
37.5	7W	9	SE 1/4 SW 1/4	15.0	1948
				<u>54.0</u>	

15. If the ground water supply is supplemental to an existing water supply, identification of any application for a permit, permit, certificate or adjudicated right to appropriate water made or held by the registrant.

none

Township 38S Range 2W W.M.
North

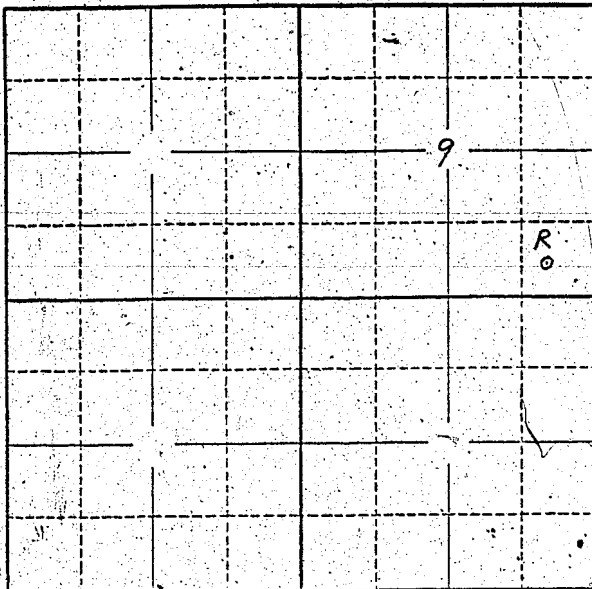

Locate well and acreage of irrigated land on plat.
Scale: 2" = 1 Mile

STATE OF OREGON

County of Josephine } ss.

I, Raymond L. Frost and Louella R. Frost, being first duly sworn, do hereby certify that I have read the foregoing Registration Statement and that all of the items therein contained are true to the best of my knowledge and belief.

Raymond L. Frost
(Signature of Registrant)

Subscribed and sworn to before me this 31st day of July, 1958

My commission expires Dec. 18th '60 Stella M. Stengel
(Notary Public)

(SEAL)

CERTIFICATE OF REGISTRATION

STATE OF OREGON

County of Marion } ss.

This is to certify that the foregoing Registration Statement was received in the office of the State Engineer on the 1st day of August, 1958, at 2:00 o'clock PM and has been duly recorded in said office in Book No. 16 of Registration Statements on page GR-3860

Witness my hand this 28th day of December, 1959

Laura J. Stanley
(State Engineer)

By _____
(Deputy)

\$18.00