

RECEIVED  
AUG 4 1958  
STATE ENGINEER  
SALEM, OREGON

REGISTRATION NO. GR-4097  
CERTIFICATE NO. GR-3686

# Registration Statement

## OF CLAIMANT OF RIGHT TO APPROPRIATE GROUND WATER

(Under Chapter 708, Oregon Laws 1955.)

TO THE STATE ENGINEER OF OREGON:

I, Robert E. Sly

of Rt 2 Box 183 Creswell

County of Lane

State of Oregon

do hereby make application for a certificate of registration as evidence of a right to appropriate ground water.

1. Source from which water is withdrawn is Pond dug in old slough bed

(Flowing well, pump well, infiltration trench, or tunnel)

2. Location is: 2 1/2 mi. N. E. of Creswell, Oregon

(Approximate distance and direction from nearest city or town)

and is more particularly described as follows: 400 feet North & 600 feet west from SEC. Section 1.

(a) 3128.1 ft N 77° 50' W to N.W. Cor. John M. Morss D. E. C. # 38

(Give distance and bearing to corner of section or other legal subdivision)

being within D. L. C. # 38

(Smallest legal subdivision)

of Sec. 1

Twp. 19 S

Rge. R. 3 W M

(N. or S.)

(E. or W.)

or (b) within limits of recorded platted property, town or city:

in Lot \_\_\_\_\_, Block \_\_\_\_\_ of \_\_\_\_\_

(Name of plat or addition)

County of \_\_\_\_\_

(If within city or town, give name)

3. Construction Work was begun on May 31, 1952

(Date)

; was completed on June 1, 1952

(Date)

and the ground water claimed was first used for the purposes set out below on June 5, 1952

(Date)

since which time the water has been used intermittently

(Continuously or Intermittently)

from June 5, 1952 to July 1958

(Date)

(Date)

4. Quantity of water claimed and used is 550 gallons per minute; 200 acre feet per year.

5. Purpose or Purposes for which water is used Irrigation

(Domestic, irrigation, municipal, manufacturing, industrial, etc.)

6. Description of Well: Depth 12 feet. Type Dug

(Dug or drilled)

diameter 40 x 80 ft inches Elevation of ground at well site 500 plus feet, mean sea level.

(As near as known)

Depth to water table, surface \_\_\_\_\_ feet.

no test

7. Capacity of Well: \_\_\_\_\_ g.p.m. with \_\_\_\_\_ feet drawdown.

\_\_\_\_\_ g.p.m. with \_\_\_\_\_ feet drawdown.

Date of test \_\_\_\_\_

If Flowing Well: Measured discharge \_\_\_\_\_ g.p.m. on \_\_\_\_\_

(Date)

Shut-in pressure at ground surface \_\_\_\_\_ lbs. per sq. in. on \_\_\_\_\_

(Date)


Water is controlled by \_\_\_\_\_

(Cap, valve, etc.)





Township 19S Range 34 W.M.  
North

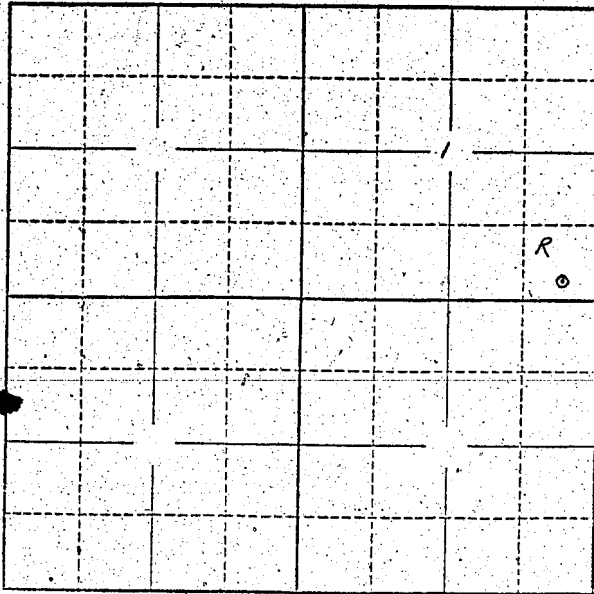

Locate well and acreage of irrigated land on plat.  
Scale: 2" = 1 Mile

STATE OF OREGON

County of Lane } ss.

I, Robert E. Sly, being first duly sworn, do hereby certify that I have read the foregoing Registration Statement and that all of the items therein contained are true to the best of my knowledge and belief.

Robert E. Sly  
(Signature of Registrant)

Subscribed and sworn to before me this 2 day of Aug, 1958

My commission expires May 24, 1959

[Signature]  
(Notary Public)

(SEAL)

CERTIFICATE OF REGISTRATION

STATE OF OREGON

County of Marion } ss.

This is to certify that the foregoing Registration Statement was received in the office of the State Engineer on the 4<sup>th</sup> day of August, 1958, at 2:00 o'clock A. M. and has been duly recorded in said office in Book No. 15 of Registration Statements on page OR-3686

~~xx Construction shall be completed by the date specified on the certificate of registration and the certificate shall be filed in the office of the State Engineer.~~

Witness my hand this 20<sup>th</sup> day of October, 1958

Lewis A. Stanley  
(State Engineer)

\$ 22.50

By \_\_\_\_\_ (Deputy)

OR-3686