

RECEIVED  
AUG 4 1958

# Registration Statement

STATE ENGINEER OF CLAIMANT OF RIGHT TO APPROPRIATE GROUND WATER  
SALEM, OREGON

TO THE STATE ENGINEER OF OREGON:

I, JOHN B. ENDRICOTT  
of 9380 McKenzie Hwy, Springfield County of Hamilton  
State of Ore, do hereby make application for a certificate of registration as evidence  
of a right to appropriate ground water.

1. Source from which water is withdrawn is Pump Well  
(Flowing well, pump well, infiltration trench, or tunnel)

2. Location is: eight miles east Springfield Ore  
(Approximate distance and direction from nearest city or town)

and is more particularly described as follows: 660' N 50° E from Iron Rod - witness to SW corner NW 1/4 SW 1/4 Sec 29 T17S  
66° N 6 1/2° E of SW cor. Sec 29  
(Give distance and bearing to corner or section or other legal subdivision)

being within SW 1/4 SW 1/4 of Sec. 31, Twp. 17 S, Rge. 1 W  
(Smallest legal subdivision) (S. or S.) (E. or W.)

or (b) within limits of recorded platted property, town or city:

in Lot \_\_\_\_\_, Block \_\_\_\_\_ of \_\_\_\_\_  
(Name of plat or addition)

County of \_\_\_\_\_  
(If within city or town, give name)

3. Construction Work was begun on 25 Jul 38; was completed on 30 Jul 38  
(Date) (Date)

and the ground water claimed was first used for the purposes set out below on 30 Jul 38  
(Date)

since which time the water has been used Continuously (yearly basis)  
(Continuously or Intermittently)

from Jul 38 to present date  
(Date) (Date)

4. Quantity of water claimed and used is 200 (est.) gallons per minute; \_\_\_\_\_ acre  
feet per year.

5. Purpose or Purposes for which water is used irrigation  
(Domestic, irrigation, municipal, manufacturing, industrial, etc.)

6. Description of Well: Depth 18 feet. Type dug  
(Dug or drilled)

diameter 36 inches. Elevation of ground at well site 560 feet, mean sea level.  
(As near as known)

Depth to water table 14 feet.

7. Capacity of Well: unk. g.p.m. with \_\_\_\_\_ feet drawdown.

\_\_\_\_\_ g.p.m. with \_\_\_\_\_ feet drawdown.

Date of test N/A

If Flowing Well: Measured discharge \_\_\_\_\_ g.p.m. on \_\_\_\_\_  
(Date)


Shut-in pressure at ground surface \_\_\_\_\_ lbs. per sq. in. on \_\_\_\_\_  
(Date)

Water is controlled by \_\_\_\_\_  
(Cap, valve, etc.)





Township 17S Range 1W, W.M.  
North

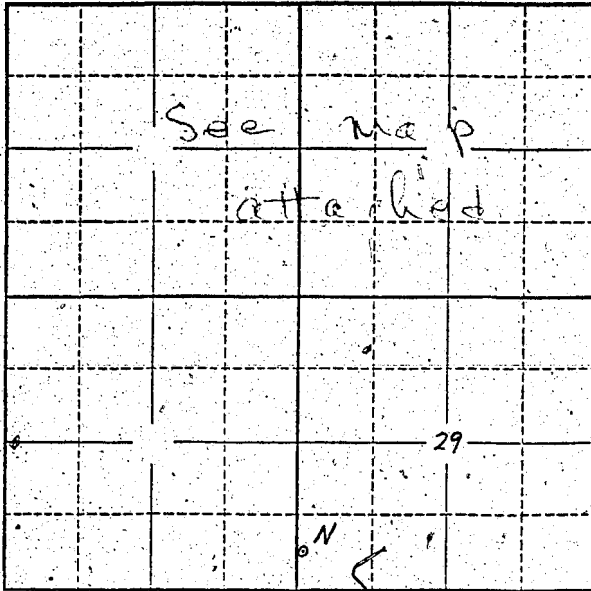

Locate well and acreage of irrigated land on plat.  
Scale: 2" = 1 Mile

STATE OF OREGON

County of Marion } ss.

I, \_\_\_\_\_, being first duly sworn, do hereby certify that I have read the foregoing Registration Statement and that all of the items therein contained are true to the best of my knowledge and belief.

B. E. ...  
(Signature of Registrant)

Subscribed and sworn to before me this 2 day of August, 1955

NOTARY PUBLIC FOR OREGON  
My commission expires Feb. 7, 1950

[Signature]  
(Notary Public)

(SEAL)

CERTIFICATE OF REGISTRATION

STATE OF OREGON

County of Marion } ss.

This is to certify that the foregoing Registration Statement was received in the office of the State Engineer on the 4th day of August, 1955, at 8:00 o'clock A. M. and has been duly recorded in said office in Book No. 15 of Registration Statements on page 28-3687

Witness my hand this 20th day of October, 1959

[Signature]  
(State Engineer)

\$15.00

By \_\_\_\_\_ (Deputy)