

RECEIVED  
AUG 4 1958

STATE ENGINEER  
SALEM, OREGON

Registration No. GR - 4099

Certificate No. GR 3688

# Registration Statement

## OF CLAIMANT OF RIGHT TO APPROPRIATE GROUND WATER

TO THE STATE ENGINEER OF OREGON:

I, John L. Shook

of Route 3, Junction City County of Benton

(Mailing address)

State of Oregon, do hereby make application for a certificate of registration as evidence of a right to appropriate ground water.

1. Source from which water is withdrawn is ump well  
(Flowing well, pump well, infiltration trench, or tunnel)

2. Location is: Ingram Island, 4 miles east of Monroe  
(Approximate distance and direction from nearest city or town)

and is more particularly described as follows: E 15' hence S 329' to SE corner, lot 25, Sec. 30,

(a) T 14S, R 1W  
(Give distance and bearing to corner of section or other legal subdivision)

being within SW 1/4 NW 1/4 of Sec. 30, Twp. 14S, Rge. 5W  
(Smallest legal subdivision) (N. or S.) (E. or W.)

or (b) within limits of recorded platted property, town or city:

in Lot \_\_\_\_\_, Block \_\_\_\_\_ of \_\_\_\_\_  
(Name of plat or addition)

(If within city or town, give name)

County of \_\_\_\_\_

3. Construction Work was begun on 1945; was completed on 1945  
(Date) (Date)

and the ground water claimed was first used for the purposes set out below on 1945  
(Date)

since which time the water has been used continuously  
(Continuously or Intermittently)

from 1945 to 1958  
(Date) (Date)

4. Quantity of water claimed and used is 200 when pumping \_\_\_\_\_ gallons per minute; \_\_\_\_\_ acre feet per year.

5. Purpose or Purposes for which water is used irrigation

(Domestic, irrigation, municipal, manufacturing, industrial, etc.)

6. Description of Well: Depth 21 feet. Type driven  
(Dug or drilled)

diameter 4 inches. Elevation of ground at well site 255 feet, mean sea level.  
(As near as known)

Depth to water table 12 feet.

7. Capacity of Well: 200 plus suck directly from casing \_\_\_\_\_ feet drawdown.

\_\_\_\_\_ g.p.m. with \_\_\_\_\_ feet drawdown.

Date of test 1945

If Flowing Well: Measured discharge \_\_\_\_\_ g.p.m. on \_\_\_\_\_  
(Date)

Shut-in pressure at ground surface \_\_\_\_\_ lbs. per sq. in. on \_\_\_\_\_  
(Date)

Water is controlled by \_\_\_\_\_  
(Cap. valve, etc.)

8. Casing: (Give diameter, commercial specifications and depth below ground surface of each casing size.)

4 inch diameter steel casing from surface to 21 feet  
 inch diameter from to feet  
 inch diameter from to feet  
 inch diameter from to feet

Describe and show depth of shoe, plug, adapter, liner or other details:

9. Perforated Casings or Screens:

slotted, size and number unknown from 16 to 21'  
(Number per foot and size of perforations, or describe screen)  
 from to  
 from to  
 from to

10. Log of Well: (Describe each stratum or formation clearly, indicate if water bearing, and give thickness and depth as indicated.)

MATERIAL	Thickness (Feet)	Depth to Bottom (Feet)
unknown		

If log of well is not available, give name and address of driller. unknown

11. Infiltration Trench: Covered or open .....

Dimensions: Length ..... ft. Minimum depth ..... ft. Maximum depth ..... ft.

Bottom width ..... ft. Discharge ..... g.p.m. Date of test .....

12. Tunnel: Type of lining .....

Dimensions: .....  
(Length, course, and cross sectional size)

Position of water bearing stratum with reference to portal of tunnel .....

Log of tunnel: (Preceding table for log of well may be used, if desired. Give footage from portal and character of materials, as pertinent.)

13. Pumping Equipment:

(a) Pump 2 1/2 x 2 Fairbanks Morse centrifugal Capacity 250 g.p.m.  
(Make, type and size)


(b) Motor J. D. tractor, stove oil, 2 1/2 hp  
(Type and horsepower)

14. Location of area irrigated or to be irrigated, or place of use if for purposes other than irrigation.

Township North or South	Range E. or W. of Willamette Meridian	Section	Forty-acre Tract	Number Acres To Be Irrigated	Date of Reclamation
11S	24W	30	SW 1/4 NW 1/4	5.0	1945

15. If the ground water supply is supplemental to an existing water supply, identification of any application for a permit, permit, certificate or adjudicated right to appropriate water made or held by the registrant.

Township 14S Range 5W W.M.  
North

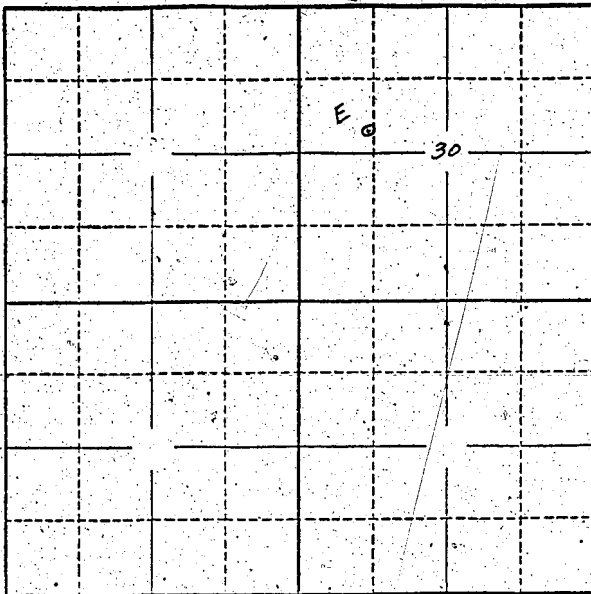

Locate well and acreage of irrigated land on plat.  
Scale: 2" = 1 Mile

STATE OF OREGON

County of Linn } ss.

I, John L. Shook, being first duly sworn, do hereby certify that I have read the foregoing Registration Statement and that all of the items therein contained are true to the best of my knowledge and belief.

*John L. Shook*  
(Signature of Registrant)

Subscribed and sworn to before me this 2nd day of August, 1958.

My commission expires August 13, 1958 [Signature]  
(Notary Public)

(SEAL)

**CERTIFICATE OF REGISTRATION**

STATE OF OREGON

County of Marion } ss.

This is to certify that the foregoing Registration Statement was received in the office of the State Engineer on the 4<sup>th</sup> day of August, 1958, at 8:00 o'clock A. M. and has been duly recorded in said office in Book No. 15 of Registration Statements on page GR 3688.

Witness my hand this 20<sup>th</sup> day of October, 1959.

*Laura A. Stanley*  
(State Engineer)

By \_\_\_\_\_ (Deputy)

\$15.00