

RECEIVED
AUG 4 1958

STATE ENGINEER
SALEM, OREGON

Registration No. GR - 4100

Certificate No. GR - 3689

Registration Statement

OF CLAIMANT OF RIGHT TO APPROPRIATE GROUND WATER

TO THE STATE ENGINEER OF OREGON:

I, John L. Shook

of Route 3, Junction City County of Benton

(Mailing address)

State of Oregon, do hereby make application for a certificate of registration as evidence of a right to appropriate ground water.

1. Source from which water is withdrawn is pump well #3
(Flowing well, pump well, infiltration trench, or tunnel)

2. Location is: Ingram Island, 4 miles east of Monroe
(Approximate distance and direction from nearest city or town)

and is more particularly described as follows:

(a) 693' N 10° 45' W to NW corner lot 26, Sec. 30, T 14S, R 5W

(Give distance and bearing to corner of section or other legal subdivision)

being within NW 1/4 SW 1/4 of Sec. 30, Twp. 14S, Rge. 14W
(Smallest legal subdivision) (N. or S.) (E. or W.)

or (b) within limits of recorded platted property, town or city:

in Lot _____, Block _____ of _____
(Name of plat or addition)

County of _____

(If within city or town, give name)

3. Construction Work was begun on 1946, was completed on 1946

(Date)

(Date)

and the ground water claimed was first used for the purposes set out below on 1946

(Date)

since which time the water has been used continuously

(Continuously or intermittently)

from 1946 to 1958

(Date)

(Date)

4. Quantity of water claimed and used is 200 when pumping, gallons per minute; 5 acre feet per year.

5. Purpose or Purposes for which water is used irrigation

(Domestic, irrigation, municipal, manufacturing, industrial, etc.)

6. Description of Well: Depth 21 feet. Type driven

(Dug or drilled)

diameter 3 inches. Elevation of ground at well site 255 feet, mean sea level.

(As near as known)

Depth to water table 12 feet.

7. Capacity of Well: 200 plus suck directly from casing g.p.m. with _____ feet drawdown.

_____ g.p.m. with _____ feet drawdown.

Date of test 1946

If Flowing Well: Measured discharge _____ g.p.m. on _____

(Date)

Shut-in pressure at ground surface _____ lbs. per sq. in. on _____

(Date)

Water is controlled by _____

(Cap, valve, etc.)

If log of well is not available, give name and address of driller. unknown

11. Infiltration trench: ~~Covered~~ or open _____
 Dimensions: Length _____ ft. Minimum depth _____ ft. Maximum depth _____ ft.
 Bottom width _____ ft. Discharge _____ g.p.m. Date of test _____

12. Tunnel: Type of lining _____
 Dimensions: _____
(Length, course, and cross sectional size)
 Position of water bearing stratum with reference to portal of tunnel _____

Log of tunnel: (Preceding table for log of well may be used, if desired. Give footage from portal and character of materials, as pertinent.)

13. Pumping Equipment:


(a) Pump 2 1/2 x 2 Fairbanks Morse centrifugal Capacity 250 g.p.m.
(Make, type and size)
 (b) Motor J. D. tractor, stove oil, 24 hp
(Type and horsepower)

14. Location of area irrigated or to be irrigated, or place of use if for purposes other than irrigation.

Township North or South	Range E. or W. of Willamette Meridian	Section	Forty-acre Tract	Number Acres To Be Irrigated	Date of Reclamation
14S	4W	30	NW 1/4 SW 1/4	2.0	1946

15. If the ground water supply is supplemental to an existing water supply, identification of any application for a permit, permit, certificate or adjudicated right to appropriate water made or held by the registrant.

Township 14S Range 4W W.M.
North

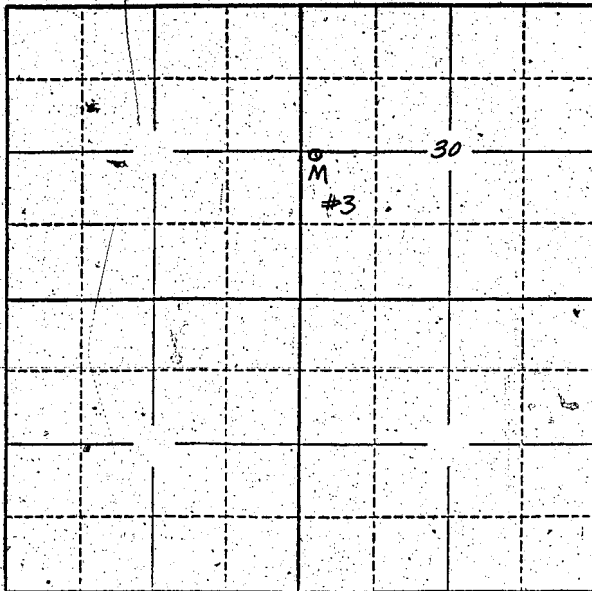

Locate well and acreage of irrigated land on plat.
Scale: 2" = 1 Mile

STATE OF OREGON

County of Linn } ss.

I, John L. Shook, being first duly sworn, do hereby certify that I have read the foregoing Registration Statement and that all of the items therein contained are true to the best of my knowledge and belief.

John L. Shook
(Signature of Registrant)

Subscribed and sworn to before me this 2nd day of August, 1958

My commission expires August 13, 1958

James B. ...
(Notary Public)

(SEAL)

CERTIFICATE OF REGISTRATION

STATE OF OREGON

County of Marion } ss.

This is to certify that the foregoing Registration Statement was received in the office of the State Engineer on the 4th day of August, 1958, at 8:00 o'clock A. M. and has been duly recorded in said office in Book No. 15 of Registration Statements on page GR-3689

Witness my hand this 20th day of October, 1959

Lawrence A. Stanley
(State Engineer)

\$15.00

By _____ (Deputy)

GR 3689