

RECEIVED  
AUG 4 1958

# Registration Statement

## CLAIMANT OF RIGHT TO APPROPRIATE GROUND WATER

RECEIVED  
APR 11 1950

STATE ENGINEER  
SALEM, OREGON

TO THE STATE ENGINEER OF OREGON:

I, Harold W. Busby  
of Route 1 Box 75 Independence County of Polk  
(Mailing address)

State of Oregon do hereby make application for a certificate of registration as evidence of a right to appropriate ground water.

1. Source from which water is withdrawn is Pump Well  
(Flowing well, pump well, infiltration trench, or tunnel)

2. Location is: Three South + East of Independence  
(Approximate distance and direction from nearest city or town)

and is more particularly described as follows:

(a) 100 feet North & 200 feet East from E 1/4 corner Section 14  
(Give distance and bearing to corner of section or other legal subdivision)

being within 34.95 South 7 1/2 West of Sec. 14, Twp. 9 S, Rge. 4 W  
(Smallest legal subdivision) (N. or S.) (E. or W.)

or (b) within limits of recorded platted property, town or city:

in Lot 30, Block 2 of Willamette Meridian  
(Name of plat or addition)

County of Polk  
(If within city or town, give name)

3. Construction Work was begun on 1950; was completed on 1950  
(Date) (Date)

and the ground water claimed was first used for the purposes set out below on 1950  
(Date)

since which time the water has been used Continuously  
(Continuously or Intermittently)

from 1950 to Aug 1958  
(Date) (Date)

*about 30 days a year  
" 10 days a day*

4. Quantity of water claimed and used is 45 to 60 gallons per minute; \_\_\_\_\_ acre feet per year.

5. Purpose or Purposes for which water is used Irrigate pasture + garden  
(Domestic, irrigation, municipal, manufacturing, industrial, etc.)

6. Description of Well: Depth 38 feet. Type Driven  
(Dug or drilled)

diameter 4 inches. Elevation of ground at well site approx 132 feet, mean sea level.  
(As near as known)

Depth to water table 22 feet.

7. Capacity of Well: \_\_\_\_\_ g.p.m. with \_\_\_\_\_ feet drawdown.  
\_\_\_\_\_ g.p.m. with \_\_\_\_\_ feet drawdown.

Date of test Never tested

If Flowing Well: Measured discharge \_\_\_\_\_ g.p.m. on \_\_\_\_\_  
(Date)

Shut-in pressure at ground surface \_\_\_\_\_ lbs. per sq. in. on \_\_\_\_\_  
(Date)

Water is controlled by Valve  
(Cap, valve, etc.)

8. Casing: (Give diameter, commercial specifications and depth below ground surface of each casing size.)

4 inch diameter *28 ft long* from *10* to *38* feet  
 inch diameter from to feet  
 inch diameter from to feet  
 inch diameter from to feet

Describe and show depth of shoe, plug, adapter, liner or other details:  
 \_\_\_\_\_  
 \_\_\_\_\_

9. Perforated Casings or Screens:

(Number per foot and size of perforations, or describe screen) from to  
*Buried in slots last 6 ft of casing* from to  
*1/4 x 1/4" long* from to  
 from to

10. Log of Well: (Describe each stratum or formation clearly, indicate if water bearing, and give thickness and depth as indicated.)

MATERIAL	Thickness (Feet)	Depth to Bottom (Feet)
<i>1st 8ft sandy loam formation</i>		
<i>rest of formation to 38ft is small</i>		
<i>gravel as far as is known</i>		

If log of well is not available, give name and address of driller: *myself*

11. Infiltration Trench: Covered or open \_\_\_\_\_  
 Dimensions: Length \_\_\_\_\_ ft. Minimum depth \_\_\_\_\_ ft. Maximum depth \_\_\_\_\_ ft.  
 Bottom width \_\_\_\_\_ ft. Discharge \_\_\_\_\_ g.p.m. Date of test \_\_\_\_\_

12. Tunnel: Type of lining \_\_\_\_\_  
 Dimensions: \_\_\_\_\_  
(Length, course, and cross sectional size)  
 Position of water bearing stratum with reference to portal of tunnel \_\_\_\_\_

Log of tunnel: (Preceding table for log of well may be used, if desired. Give footage from portal and character of materials, as pertinent.)


13. Pumping Equipment:  
 (a) Pump *Portland Pipe & Power Co. Model 11* Capacity \_\_\_\_\_ g.p.m.  
(Make, type and size) *1 1/2" inlet 1" outlet*  
 (b) Motor *Master 3HP. Type RA. R.P.M. 3450*  
(Type and horsepower)

14. Location of area irrigated or to be irrigated, or place of use if for purposes other than irrigation.

Township North or South	Range E. or W. of Willamette Meridian	Section	Forty-acre Tract	Number Acres To Be Irrigated	Date of Reclamation
9 S	4 W	14	<del>14</del>	<del>6.00</del>	1950
"	"	"	SE 1/4 of NE 1/4	2.0	"
"	"	"	NE 1/4 of SE 1/4	4.0	"
				6.0 Total	"

15. If the ground water supply is supplemental to an existing water supply, identification of any application for a permit, permit, certificate or adjudicated right to appropriate water made or held by the registrant.

Township 9S Range 4W, W.M.  
North

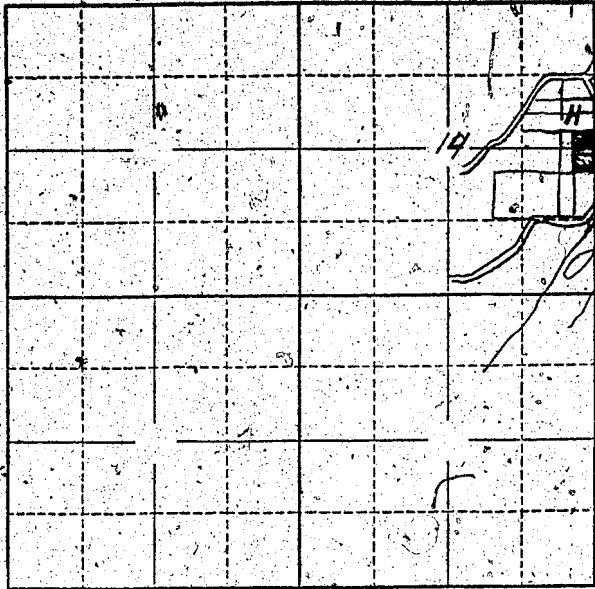

Locate well and acreage of irrigated land on plat.  
Scale: 2" = 1 Mile

STATE OF OREGON

County of Peck } ss.

I, Harold W. Bushy, being first duly sworn, do hereby certify that I have read the foregoing Registration Statement and that all of the items therein contained are true to the best of my knowledge and belief.

Harold W. Bushy  
(Signature of Registrant)

Subscribed and sworn to before me this 2nd day of August, 1958

My commission expires 12-31-60

(Notary Public)

(SEAL)

**CERTIFICATE OF REGISTRATION**

STATE OF OREGON } ss.  
County of Marion

This is to certify that the foregoing Registration Statement was received in the office of the State Engineer on the 4th day of August, 1958, at 8:00 o'clock A. M. and has been duly recorded in said office in Book No. 17 of Registration Statements on page GR-4065

Witness my hand this 16th day of May, 1960

Laura A. Stanley  
(State Engineer)

By \_\_\_\_\_ (Deputy)

GR 4065