

Registration Statement

OF CLAIMANT OF RIGHT TO APPROPRIATE GROUND WATER

TO THE STATE ENGINEER OF OREGON:

I, CLEO HINKHOUSE

of 330 N. CLOVER RIDGE ROAD, ALBANY County of LINN

State of OREGON do hereby make application for a certificate of registration as evidence of a right to appropriate ground water.

- 1. Source from which water is withdrawn is PUMP WELL
(Flowing well, pump well, infiltration trench, or tunnel)
- 2. Location is: 2 MILES N. OF JEFFERSON, ORE.
(Approximate distance and direction from nearest city or town)

and is more particularly described as follows:

(a) 295' N AND 222' E OF SW COR. S. 31, T. 22, R. 36
(Give distance and bearing to corner of section or other legal subdivision)

being within SW 1/4 OF SW 1/4 of Sec. 36, Twp. 22, Rge. 36
(Smallest legal subdivision) (N. or S.) (E. or W.)

or (b) within limits of recorded platted property, town or city:

in Lot _____, Block _____ of _____
(Name of plat or addition)
County of MARION
(If within city or town, give name)

3. Construction Work was begun on 1954; was completed on 1954
(Date) (Date)

and the ground water claimed was first used for the purposes set out below on JUNE 1956
(Date)

since which time the water has been used CONTINUOUSLY
(Continuously or intermittently)

from JUNE 1956 to OCTOBER 1956
(Date) (Date)

4. Quantity of water claimed and used is 240 gallons per minute; 36.0 acre feet per year.

5. Purpose or Purposes for which water is used IRRIGATION
(Domestic, irrigation, municipal, manufacturing, industrial, etc.)

6. Description of Well: Depth 27 feet. Type DRILLED
(Dug or drilled)

diameter 4 inches. Elevation of ground at well site 220 feet, mean sea level.
(As near as known)

Depth to water table 10 feet.

7. Capacity of Well: _____ g.p.m. with _____ feet drawdown.
_____ g.p.m. with _____ feet drawdown.


Date of test NOT TESTED

If Flowing Well: Measured discharge _____ g.p.m. on _____
(Date)

Shut-in pressure at ground surface _____ lbs. per sq. in. on _____
(Date)

Water is controlled by _____
(Cap, valve, etc.)

Township 9S Range 3W W.M.
North

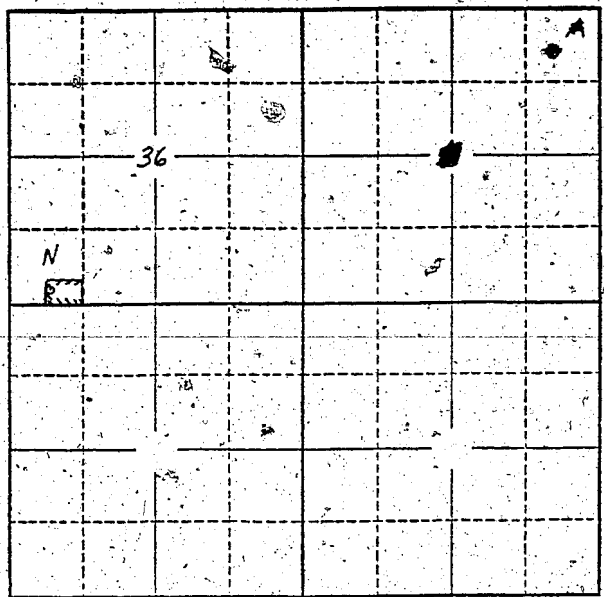

Locate well and acreage of irrigated land on plat.
Scale: 2" = 1 Mile

STATE OF OREGON }
County of LINN } ss.

I, CLEO HINKHOUSE, being first duly sworn, do hereby certify that I have read the foregoing Registration Statement and that all of the items therein contained are true to the best of my knowledge and belief.

Cleo Hinkhouse
(Signature of Registrant)

Subscribed and sworn to before me this 1st day of August, 1958

My commission expires MY COMMISSION EXPIRES MAY 22, 1962
Lois E. Phillips
(Notary Public)

(SEAL)

CERTIFICATE OF REGISTRATION

STATE OF OREGON }
County of Marion } ss.

This is to certify that the foregoing Registration Statement was received in the office of the State Engineer on the 4th day of August, 1958, at 1:00 o'clock A. M. and has been duly recorded in said office in Book No. 15 of Registration Statements on page GR-3091.

Witness my hand this 20th day of October, 1959

Lawrence A. Stanley
(State Engineer)

By _____
(Deputy)

\$ 15.00

GR 3691