

Well #1

GR 411

Registration Statement

STATION NO. ~~68-800~~

CERTIFICATE NO. 394

OF CLAIMANT OF RIGHT TO APPROPRIATE GROUND WATER

(Under Chapter 768, Oregon Laws 1955.)

TO THE STATE ENGINEER OF OREGON:

I, Autis Hayes, R#1, Box #6, Turner, Oregon
of _____ County of Marion

State of Oregon, do hereby make application for a certificate of registration as evidence of a right to appropriate ground water.

1. Source from which water is withdrawn is Pump Well #1
(Flowing well, pump well, infiltration trench, or tunnel)

2. Location is: 1 1/2 miles south of Marion
(Approximate distance and direction from nearest city or town)

and is more particularly described as follows:

(a) 690 feet south and 920 feet west from center of section 4.
(Give distance and bearing to corner of section or other legal subdivision)

being within NE 1/4 of SW 1/4 of Sec. 4, Twp. 10 S., Rge. 20
(Smallest legal subdivision) (N. or S.) (E. or W.)

or (b) within limits of recorded platted property, town or city: _____

in Lot _____, Block _____ of _____
(Name of plat or addition)

County of _____
(If within city or town, give name)

3. Construction Work was begun on 1939; was completed on April 1939
(Date) (Date)

and the ground water claimed was first used for the purposes set out below on same 1939
(Date)

since which time the water has been used intermittently
(Continuously or Intermittently)

from 1939 to March 25, 1957
(Date) (Date)

4. Quantity of water claimed and used is 750 gallons per minute; _____ acre feet per year.

5. Purpose or Purposes for which water is used irrigation

(Domestic, irrigation, municipal, manufacturing, industrial, etc.)

6. Description of Well: Depth 27 feet. Type dug
(Dug or drilled)

diameter 8 inches. Elevation of ground at well site 278 feet, mean sea level.
(As near as known)

Depth to water table _____ feet.

7. Capacity of Well: _____ g.p.m. with _____ feet drawdown.

_____ g.p.m. with _____ feet drawdown.

Date of test _____

If Flowing Well: Measured discharge _____ g.p.m. on _____
(Date)

Shut-in pressure at ground surface _____ lbs. per sq. in. on _____
(Date)

Water is controlled by _____
(Cap, valve, etc.)



8. Casing: (Give diameter, commercial specifications and depth below ground surface of each casing size.)

8 inch diameter from Top to 2.9 feet

..... inch diameter from to feet

..... inch diameter from to feet

..... inch diameter from to feet

Describe and show depth of shoe, plug, adapter, liner or other details:

.....

9. Perforated Casings or Screens:

15 ft 1/2 inch from to

(Number per foot and size of perforations, or describe screen)

..... from to

..... from to

..... from to

10. Log of Well: (Describe each stratum or formation clearly, indicate if water bearing, and give thickness and depth as indicated.)

MATERIAL	Thickness (Feet)	Depth to Bottom (Feet)

If log of well is not available, give name and address of driller. *West*

11. Infiltration Trench: Covered or open

Dimensions: Length ft. Minimum depth ft. Maximum depth ft.

Bottom width ft. Discharge g.p.m. Date of test

12. Tunnel: Type of lining

Dimensions:
(Length, course, and cross sectional size)

Position of water bearing stratum with reference to portal of tunnel

Log of tunnel: (Preceding table for log of well may be used, if desired. Give footage from portal and character of materials, as pertinent.)

13. Pumping Equipment:

(a) Pump *Fairbanks Morse* Capacity g.p.m.
(Make, type and size)


(b) Motor *2.5 horsepower motor*
(Type and horsepower)

14. Location of area irrigated or to be irrigated, or place of use if for purposes other than irrigation.

Township North or South	Range E. or W. of Willamette Meridian	Section	Forty-acre Tract	Number Acres To Be Irrigated	Date of Reclamation
<i>10 S</i>	<i>2 W</i>	<i>4</i>	<i>NE 1/4 SW 1/4</i>	<i>27 2/3</i>	<i>1939</i>
			<i>NW 1/4 SW 1/4</i>	<i>1 2/3</i>	<i>1939</i>
			<i>NW 1/4 SE 1/4</i>	<i>4 5/8</i>	
				<i>33.3</i>	

15. If the ground water supply is supplemental to an existing water supply, identification of any application for a permit, permit, certificate or adjudicated right to appropriate water made or held by the registrant.

Township 12S Range 2W W.M.
North

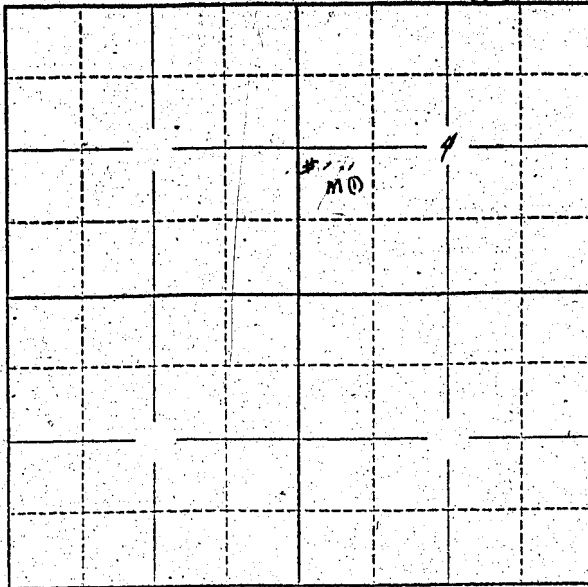

Locate well and acreage of irrigated land on plat.
Scale: 2" = 1 Mile

STATE OF OREGON }
County of Marion } ss.

I, Artis Hayes, being first duly sworn, do hereby certify that I have read the foregoing Registration Statement and that all of the items therein contained are true to the best of my knowledge and belief.

Artis Hayes
(Signature of Registrant)

Subscribed and sworn to before me this 25 day of April, 1957

My commission expires April 6, 1959 Wm. Blinn
(Notary Public)

(SEAL)

See Page GR-394 G for
CERTIFICATE OF REGISTRATION

STATE OF OREGON }
County of Marion } ss.

~~This is to certify that the foregoing Registration Statement was received in the office of the State Engineer on the 25 day of April 1957 at 10 o'clock AM and has been duly recorded in said office in Book No. of Registration Statements on page . Construction shall be completed by 1957 and the water completely applied to beneficial use by 1957.~~

Witness my hand this day of , 19

(State Engineer)
By
(Deputy)

Well #2

REGISTRATION NO. 64-411
CERTIFICATE NO. 394

Registration Statement

OF CLAIMANT OF RIGHT TO APPROPRIATE GROUND WATER
(Under Chapter 702, Oregon Laws 1953.)

TO THE STATE ENGINEER OF OREGON:

I, Autis Hayes, R#1, Box 86, Turner, Oregon
of Marion County of Oregon

State of Oregon, do hereby make application for a certificate of registration as evidence of a right to appropriate ground water.

- 1. Source from which water is withdrawn is Pump Well #2
(Flowing well, pump well, infiltration trench, or tunnel)
- 2. Location is: 1/2 mile south of Marion
(Approximate distance and direction from nearest city or town)

and is more particularly described as follows:

- (a) 320' S of 1800' W of center of Sec. 4
(Give distance and bearing to corner of section or other legal subdivision)
being within NW 1/4 SW 1/4 of Sec. 4, Twp. 109, Rge. 2 W
(Smallest legal subdivision) (N. or S.) (E. or W.)
- or (b) within limits of recorded platted property, town or city: _____
in Lot _____, Block _____ of _____
(Name of plat or addition)
County of _____
(If within city or town, give name)

3. Construction Work was begun on 1939; was completed on April 1939
(Date) (Date)
and the ground water claimed was first used for the purposes set out below on June 1939,
(Date)
since which time the water has been used intermittently
(Continuously or intermittently)
from June 1, 1939 to March 25, 1957
(Date) (Date)

4. Quantity of water claimed and used is 750 gallons per minute; _____ acre feet per year.

5. Purpose or Purposes for which water is used irrigation
(Domestic, irrigation, municipal, manufacturing, industrial, etc.)

6. Description of Well: Depth 29 feet. Type drilled
(Bog or drilled)
diameter 8 inches. Elevation of ground at well site 278 feet, mean sea level.
(As near as known)
Depth to water table _____ feet.

7. Capacity of Well: _____ g.p.m. with _____ feet drawdown.
_____ g.p.m. with _____ feet drawdown.
Date of test _____
If Flowing Well: Measured discharge _____ g.p.m. on _____
(Date)
Shut-in pressure at ground surface _____ lbs. per sq. in. on _____
(Date)
Water is controlled by _____
(Cap, valve, etc.)

GR - 394 D

8. Casings: (Give diameter, commercial specifications and depth below ground surface of each casing size.)

8 inch diameter from Top to 29 feet
..... inch diameter from to feet
..... inch diameter from to feet
..... inch diameter from to feet

Describe and show depth of shoe, plug, adapter, liner or other details:
.....
.....

9. Perforated Casings or Screens:

15 ft . 1/2 inch from to
(Number per foot and size of perforations, or describe screen)
..... from to
..... from to
..... from to

10. Log of Well: (Describe each stratum or formation clearly, indicate if water bearing, and give thickness and depth as indicated.)

MATERIAL	Thickness (Feet)	Depth to Bottom (Feet)

If log of well is not available, give name and address of driller. West -

Salem, Oregon

11. Infiltration Trench: Covered or open

Dimensions: Length ft. Minimum depth ft. Maximum depth ft.

Bottom width ft. Discharge g.p.m. Date of test

12. Tunnel: Type of lining

Dimensions:
(Length, course, and cross sectional size)

Position of water bearing stratum with reference to portal of tunnel

Log of tunnel: (Preceding table for log of well may be used, if desired. Give footage from portal and character of materials, as pertinent.)

13. Pumping Equipment:

(a) Pump Jarbanks Morse Capacity g.p.m.
(Make, type and size)


(b) Motor 25 Horse motor
(Type and horsepower)

14. Location of area irrigated or to be irrigated, or place of use if for purposes other than irrigation.

Township North or South	Range E. or W. of Willamette Meridian	Section	Forty-acre Tract	Number Acres To Be Irrigated	Date of Reclamation
10 S	2 W	4	SW ¹ / ₄ NW ¹ / ₄	17	1939
"	"	"	NW ¹ / ₄ SW ¹ / ₄	17	1939
				<u>18</u>	

15. If the ground water supply is supplemental to an existing water supply, identification of any application for a permit, permit, certificate or adjudicated right to appropriate water made or held by the registrant.

Township 10S Range 2W, W.M.
North

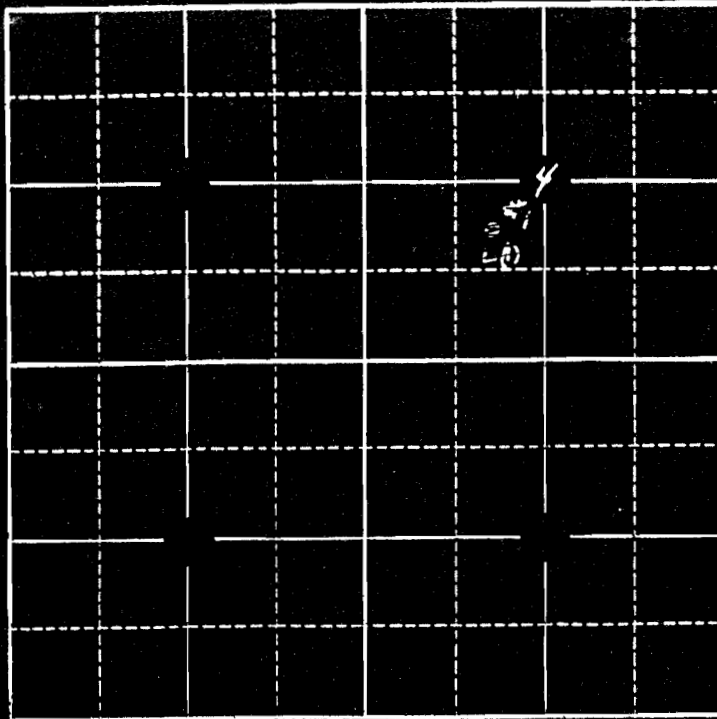

Locate well and acreage of irrigated land on plat.
Scale: 2" = 1 Mile

STATE OF OREGON }
County of Marion } ss.

I, Artes Hayes, being first duly sworn, do hereby certify that I have read the foregoing Registration Statement and that all of the items therein contained are true to the best of my knowledge and belief.

Artes Hayes
(Signature of Registrant)

Subscribed and sworn to before me this 25 day of April, 1957

My commission expires April 6, 1959
Wm. Bliven
(Notary Public)

(SEAL)

CERTIFICATE OF REGISTRATION

STATE OF OREGON }
County of Marion } ss.

This is to certify that the foregoing Registration Statement was received in the office of the State Engineer on the 25th day of March, 1957, at 8:00 o'clock A.M. and has been duly recorded in said office in Book No. 3 of Registration Statements on page GR-394 C.

~~Construction shall be completed by X-X-X-X-X-X-X-X, 19 X-X, and the water completely applied to beneficial use by X-X-X-X-X-X-X-X, 19 X-X-X-X~~

Witness my hand this 23rd day of May, 1957

Lewis A. Stanley
(State Engineer)

\$ 18.30

By _____
(Deputy)

GR - 394 G