

RECEIVED  
AUG 4 1958

STATE ENGINEER  
SALEM, OREGON

REGISTRATION NO. GR-411  
CERTIFICATE NO. GR-3695

### Registration Statement

#### OF CLAIMANT OF RIGHT TO APPROPRIATE GROUND WATER

(Under Chapter 708, Oregon Laws 1955.)

TO THE STATE ENGINEER OF OREGON:

I, Elliott N Butler

of Rt. 1 Corvallis County of Benton

State of Oregon, do hereby make application for a certificate of registration as evidence of a right to appropriate ground water.

1. Source from which water is withdrawn is Pump well (2)  
(Flowing well, pump well, infiltration trench, or tunnel)

2. Location is: 4 miles northeast of Corvallis  
(Approximate distance and direction from nearest city or town)

and is more particularly described as follows:

(a) 11.0 chains north and 5.7 chains west from 1/4 Sec. cor. on south line of Sec. 8  
(Give distance and bearing to corner of section or other legal subdivision)

being within SE 1/4 of the SW 1/4 of Sec. 8, Twp. 11 S., Rge. 4 W.  
(Smallest legal subdivision) (N. or S.) (E. or W.)

or (b) within limits of recorded platted property, town or city:

in Lot \_\_\_\_\_, Block \_\_\_\_\_ of \_\_\_\_\_  
(Name of plat or addition)

County of \_\_\_\_\_  
(If within city or town, give name)

3. Construction Work was begun on May 1 1952; was completed on May 15th 1952  
(Date) (Date)

and the ground water claimed was first used for the purposes set out below on June 15 1952  
(Date)

since which time the water has been used Intermittently  
(Continuously or Intermittently)

from June 1 1952 to Oct 1st 1952 Each year.  
(Date) (Date)

4. Quantity of water claimed and used is 300 gallons per minute; 2 acre feet per year.

5. Purpose or Purposes for which water is used Irrigation Farm Crops

(Domestic, irrigation, municipal, manufacturing, industrial, etc.)

6. Description of Well: Depth 24 feet. Type Drilled  
(Dug or drilled)

diameter 8 inches. Elevation of ground at well site 200 feet, mean sea level.  
(As near as known)

Depth to water table 3 feet.

7. Capacity of Well: 400 g.p.m. with 10 feet drawdown.

\_\_\_\_\_ g.p.m. with \_\_\_\_\_ feet drawdown.

Date of test May 15th 1952

If Flowing Well: Measured discharge \_\_\_\_\_ g.p.m. on \_\_\_\_\_  
(Date)

Shut-in pressure at ground surface \_\_\_\_\_ lbs. per sq. in. on \_\_\_\_\_  
(Date)

Water is controlled by \_\_\_\_\_  
(Cap, valve, etc.)

8. Casing: (Give diameter, commercial specifications and depth below ground surface of each casing size.)

6 inch diameter ..... from 0 to 20 feet  
 ..... inch diameter ..... from ..... to ..... feet  
 ..... inch diameter ..... from ..... to ..... feet  
 ..... inch diameter ..... from ..... to ..... feet

Describe and show depth of shoe, plug, adapter, liner or other details: .....

9. Perforated Casings or Screens:

(Number per foot and size of perforations, or describe screen) ..... from ..... to .....  
 ..... from ..... to .....  
 ..... from ..... to .....  
 ..... from ..... to .....

10. Log of Well: (Describe each stratum or formation clearly, indicate if water bearing, and give thickness and depth as indicated.)

MATERIAL	Thickness (Feet)	Depth to Bottom (Feet)

If log of well is not available, give name and address of driller. C. A. Shaffer

Philomath Oregon

**11. Infiltration Trench: Covered or open**

Dimensions: Length \_\_\_\_\_ ft. Minimum depth \_\_\_\_\_ ft. Maximum depth \_\_\_\_\_ ft.

Bottom width \_\_\_\_\_ ft. Discharge \_\_\_\_\_ g.p.m. Date of test \_\_\_\_\_

**12. Tunnel: Type of lining**

Dimensions: \_\_\_\_\_  
(Length, course, and cross sectional size)

Position of water bearing stratum with reference to portal of tunnel \_\_\_\_\_

Log of tunnel: (Preceding table for log of well may be used, if desired. Give footage from portal and character of materials, as pertinent.)

**13. Pumping Equipment:**

(a) Pump Fairbanks Morse 3" Portable Capacity 360 g.p.m.  
(Make, type and size)


(b) Motor 31 HP Gas Wisconsin  
(Type and horsepower)

**14. Location of area irrigated or to be irrigated, or place of use if for purposes other than irrigation.**

Township North or South	Range E. or W. of Willamette Meridian	Section	Forty-acre Tract	Number Acres To Be Irrigated	Date of Reclamation
11 S.	4 W.	8	SW $\frac{1}{4}$ SE $\frac{1}{4}$	1.5	1952
"	"	"	SE $\frac{1}{4}$ SW $\frac{1}{4}$	16.0	"
"	"	"	SW $\frac{1}{4}$ SW $\frac{1}{4}$	1.1	"
				<u>18.6</u>	"

15. If the ground water supply is supplemental to an existing water supply, identification of any application for a permit, permit, certificate or adjudicated right to appropriate water made or held by the registrant.

Township 11S Range 4W W.M.  
North

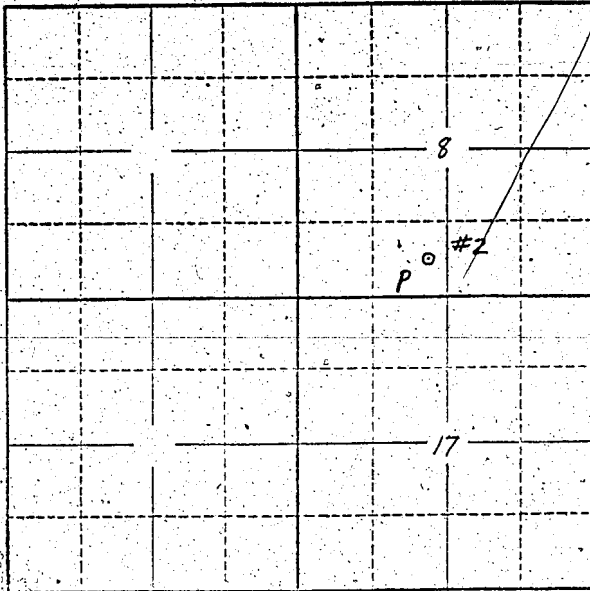

Locate well and acreage of irrigated land on plat.  
Scale: 2" = 1 Mile

STATE OF OREGON }  
County of Benton } ss.

I, Elliott N. Butler, being first duly sworn, do hereby certify that I have read the foregoing Registration Statement and that all of the items therein contained are true to the best of my knowledge and belief.

Elliott N. Butler  
(Signature of Registrant)

Subscribed and sworn to before me this 18th day of July, 1958

My commission expires 2-18-61  
Ray E. Smith  
(Notary Public)

(SEAL)

**CERTIFICATE OF REGISTRATION**

STATE OF OREGON }  
County of Marion } ss.

This is to certify that the foregoing Registration Statement was received in the office of the State Engineer on the 4th day of August, 1958, at 2:00 o'clock P. M. and has been duly recorded in said office in Book No. 15 of Registration Statements on page GR-3695

~~Construction shall be completed by 10/15/59 and the cost completely paid for~~  
~~within 10 days of 10/15/59.~~ xx

Witness my hand this 20th day of October, 1959

Levin A. Stanley  
(State Engineer)

\$15.00

By \_\_\_\_\_ (Deputy)  
GR-3695