RECEIVED
AUG 4 1958
STATE ENGINEER
SALEM, OREGON

RECISTRATION NO. GR-4112
CERTIFICATE NO. GR-3696

Registration Statement

OF CLAIMANT OF RIGHT TO APPROPRIATE GROUND WATER

(Under Chapter 708, Oregon Laws 1955.)

TO THE STATE ENGINEER OF OREGON:

I, Elliott N Butler,

of Rt 1 Corvallis County of Benton,

State of Oregon, do hereby make application for a certificate of registration as evidence of a right to appropriate ground water.

1. **Source** from which water is withdrawn is Sump ~~well~~ (borrow pit) (3)
(Flowing well, pump well, infiltration trench, or tunnel)

2. **Location** is: 4 miles northeast of Corvallis;
(Approximate distance and direction from nearest city or town)

and is more particularly described as follows:

(a) 13.6 chains North and 8.0 chains East from the ¼ sec. cor. on the South line of Sec. 8
(Give distance and bearing to corner of section or other legal subdivision)

being within SW¼ of the SE¼ of Sec. 8, Twp. 11 S., Rge. 4 W.
(Smallest legal subdivision) (N. or S.) (E. or W.)

or (b) within limits of recorded platted property, town or city:

in Lot ....., Block ..... of .....
(Name of plat or addition)

..... County of .....
(If within city or town, give name)

3. **Construction Work** was begun on Unknown (Date); was completed on unk (Date)

and the ground water claimed was first used for the purposes set out below on June 1952 (Date),

since which time the water has been used Intermittently (Continuously or intermittently)

from May each year (Date) to Oct each Year (Date)

4. **Quantity** of water claimed and used is 350 gallons per minute; ..... acre feet per year.

5. **Purpose or Purposes** for which water is used Irrigation Farm Crops
(Domestic, irrigation, municipal, manufacturing, industrial, etc.)

6. **Description of Well:** Depth Sump See Permit feet. Type Dug (Dug or drilled)

diameter ..... inches. Elevation of ground at well site 200 (As near as known) feet, mean sea level.

Depth to water table Pond feet.

7. **Capacity of Well:** ..... g.p.m. with ..... feet drawdown.

..... g.p.m. with ..... feet drawdown.

Date of test .....

If Flowing Well: Measured discharge ..... g.p.m. on ..... (Date)

Shut-in pressure at ground surface ..... lbs. per sq. in. on ..... (Date)

Water is controlled by .....
(Cap, valve, etc.)

8. **Casing:** (Give diameter, commercial specifications and depth below ground surface of each casing size.)

..... inch diameter ..... from ..... to ..... feet

..... inch diameter ..... from ..... to ..... feet

..... inch diameter ..... from ..... to ..... feet

..... inch diameter ..... from ..... to ..... feet

Describe and show depth of shoe, plug, adapter, liner or other details: .....

.....

.....

9. **Perforated Casings or Screens:**

..... from ..... to .....
(Number per foot and size of perforations, or describe screen)

..... from ..... to .....

..... from ..... to .....

..... from ..... to .....

10. **Log of Well:** (Describe each stratum or formation clearly, indicate if water bearing, and give thickness and depth as indicated.)

MATERIAL	Thickness (Feet)	Depth to Bottom (Feet)

GR 3696

If log of well is not available, give name and address of driller. .....

.....

11. **Infiltration Trench:** Covered or open .....

Dimensions: Length ..... ft. Minimum depth ..... ft. Maximum depth ..... ft.

Bottom width ..... ft. Discharge ..... g.p.m. Date of test .....

12. **Tunnel:** Type of lining .....

Dimensions: .....
(Length, course, and cross sectional size)

Position of water bearing stratum with reference to portal of tunnel .....

.....

Log of tunnel: (Preceding table for log of well may be used, if desired. Give footage from portal and character of materials, as pertinent.)

13. **Pumping Equipment:**

(a) Pump Gas engine, Fairbanks Morse Pump portable (Make, type and size) Capacity ..... g.p.m.

(b) Motor Wisconsin 31 HP Gas engine (Type and horsepower)

14. Location of area irrigated or to be irrigated, or place of use if for purposes other than irrigation.

Township North or South	Range E. or W. of Willamette Meridian	Section	Forty-acre Tract	Number Acres To Be Irrigated	Date of Reclamation
11 S.	4 W.	8	SW¼ SE¼	8.0	1952
			~~SE¼ SW¼~~	~~16.0~~	
			~~SW¼ SW¼~~	~~11~~	
			(Auxiliary and/or supplemental to Permit No. _____)		
			(On well No. 2)		

15. If the ground water supply is supplemental to an existing water supply, identification of any application for a permit, permit, certificate or adjudicated right to appropriate water made or held by the registrant.

.....

.....

GR-3696

Township 11S Range 4W, W.M.

North

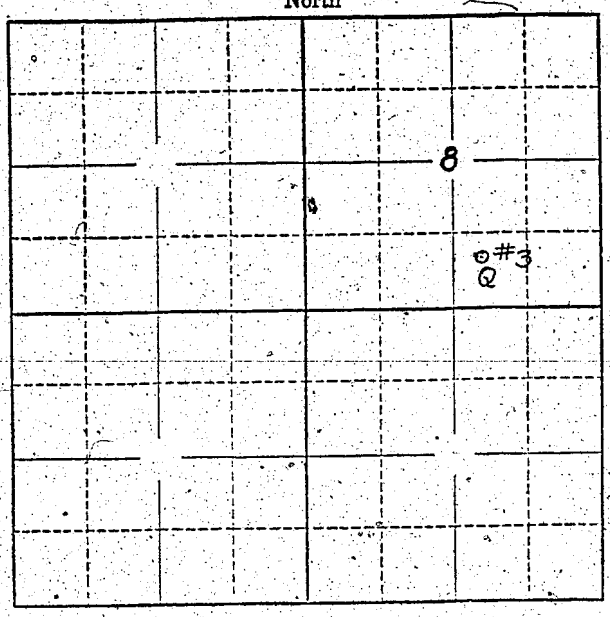

Locate well and acreage of irrigated land on plat.

Scale: 2" = 1 Mile

STATE OF OREGON
County of Benton } ss.

I, Elliott N. Butler, being first duly sworn, do hereby certify that I have read the foregoing Registration Statement and that all of the items therein contained are true to the best of my knowledge and belief.

Elliott N Butler
(Signature of Registrant)

Subscribed and sworn to before me this 18th day of July, 19 58

My commission expires 2-18-61

Rex E Smith
(Notary Public)

(SEAL)

CERTIFICATE OF REGISTRATION

STATE OF OREGON
County of Marion } ss.

This is to certify that the foregoing Registration Statement was received in the office of the State Engineer on the 4th day of August, 19 52, at 2:00 o'clock P. M. and has been duly recorded in said office in Book No. 15 of Registration Statements on page GR-3696

xx ~~Correction: [illegible] 19 [illegible] d [illegible] by [illegible] capital [illegible] 19 [illegible]~~ xx

Witness my hand this 20th day of October, 19 59

Lewis A. Stanley
(State Engineer)

$15.00

By
(Deputy)

GR-3696