

RECEIVED
AUG 1 1958
STATE ENGINEER
SALEM, OREGON

Registration No. GR. 4416

Certificate No. GR. 3699

Registration Statement

OF CLAIMANT OF RIGHT TO APPROPRIATE GROUND WATER

TO THE STATE ENGINEER OF OREGON:

I, Martin C. Goracke

of Route 3, Junction City
(Mailing address)

County of Benton

State of Oregon

, do hereby make application for a certificate of registration as evidence of a right to appropriate ground water.

1. Source from which water is withdrawn is pump well #1

(Flowing well, pump well, infiltration trench, or tunnel)

2. Location is: 4 miles east of Monroe

(Approximate distance and direction from nearest city or town)

and is more particularly described as follows:

(a) 1240' N. 67° 30' W from common/sections 25, 26, 35, 36
Corner

(Give distance and bearing to corner of section or other legal subdivision)

being within

SE 1/4 of SE 1/4
(Smallest legal subdivision)

of Sec. 26

Twp. 11S

(N. or S.)

Rge. 5W, 6W

(E. or W.)

or

(b) within limits of recorded platted property, town or city:

in Lot

, Block

of

(Name of plat or addition)

County of

(If within city or town, give name)

3. Construction Work was begun on

1941

(Date)

; was completed on

1941

(Date)

and the ground water claimed was first used for the purposes set out below on

1941

(Date)

since which time the water has been used

intermittently

(Continuously or intermittently)

from

1941

(Date)

to

1957

(Date)

4. Quantity of water claimed and used is

500

gallons per minute;

213

acre

feet per year.

5. Purpose or Purposes for which water is used

irrigation

(Domestic, irrigation, municipal, manufacturing, industrial, etc.)

6. Description of Well: Depth

15

feet. Type

dug

(Dug or drilled)

diameter 4 x 4

5

inches. Elevation of ground at well site

245

feet, mean sea level.

(As near as known)

Depth to water table

7

feet.

7. Capacity of Well:

700

g.p.m. with

6

feet drawdown.

g.p.m. with

feet drawdown.

Date of test

1941

If Flowing Well: Measured discharge

g.p.m. on

(Date)

Shut-in pressure at ground surface

lbs. per sq. in. on

(Date)

Water is controlled by

(Cap, valve, etc.)

8. Casing: (Give diameter, commercial specifications and depth below ground surface of each casing size.)

inch diameter wood cased 4 x 4 from 0 to 15 feet

inch diameter, from to feet

..... inch diameter from to feet

inch diameter from to feet

Describe and show depth of shoe, plug, adapter, liner or other details: _____

9. Perforated Casings or Screens:

from _____ to _____
(Number per foot and size of perforations, or describe screen)

..... from to

_____ from _____ to _____


_____ from _____ to _____

10. **Log of Well:** (Describe each stratum or formation clearly, indicate if water bearing, and give thickness and depth as indicated.)

[illegible]

GR 3699

Township 14S Range 5W W.M.
North

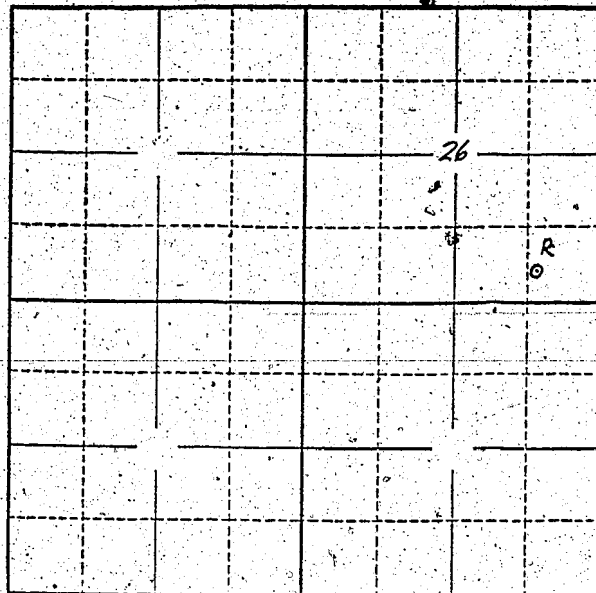

Locate well and acreage of irrigated land on plat.
Scale: 2" = 1 Mile

STATE OF OREGON

County of Linn

} ss.

I, Martin C Goracke, being first duly sworn, do hereby certify that I have read the foregoing Registration Statement and that all of the items therein contained are true to the best of my knowledge and belief.

Martin C. Goracke
(Signature of Registrant)

Subscribed and sworn to before me this 30th day of July, 1958.

My commission expires Sept. 25th., 1959

Jeany
(Notary Public)

(SEAL)

CERTIFICATE OF REGISTRATION

STATE OF OREGON

County of Marion

} ss.

This is to certify that the foregoing Registration Statement was received in the office of the State Engineer on the 14th day of August, 1958, at 8:00 o'clock A. M. and has been duly recorded in said office in Book No. 15 of Registration Statements on page GR-3699

Witness my hand this 20th day of October, 1959

23-25

Leura A. Stanley
(State Engineer)

By

(Deputy)

GR 3699