

RECEIVED
AUG 4 1958

Registration No. GR-4119

Certificate No. GR-3702

Registration Statement

STATE ENGINEER
SALEM, OREGON

OF CLAIMANT OF RIGHT TO APPROPRIATE GROUND WATER

TO THE STATE ENGINEER OF OREGON:

I, TRUIR LUMBER COMPANY

of P. O. Box 216 Wolf Creek, Oregon County of Josephine
(Mailing address)

State of Oregon, do hereby make application for a certificate of registration as evidence of a right to appropriate ground water.

1. Source from which water is withdrawn is Pump Well
(Flowing well, pump well, infiltration trench, or tunnel)

2. Location is: North of Wolf Creek, Oregon
(Approximate distance and direction from nearest city or town)

and is more particularly described as follows: About 500 feet North & 180 feet west from SW corner Section 15

(a) Approximately 100' (100 feet) from S. W. Corner of Tract 72
(Give distance and bearing to corner of section or other legal subdivision)

being within Wolf Creek Orchard Tracts of Sec. 15, Twp. 33-S, Rge. 6 W.W.M
(Smallest legal subdivision) (E. or W.)

or (b) within limits of recorded platted property, town or city:

in Lot _____ Block _____ of _____
(Name of plat or addition)

County of _____
(If within city or town, give name)

3. Construction Work was begun on 1953; was completed on May 25, 1953
(Date) (Date)

and the ground water claimed was first used for the purposes set out below on 1954
(Date)

since which time the water has been used Continuously
(Continuously or Intermittently)

from 1953 to 1958
(Date) (Date)

4. Quantity of water claimed and used is -80- gallons per minute; _____ acre feet per year.

5. Purpose or Purposes for which water is used Manufacturing and fire protection at present (exempt)

time, also for irrigation at later date
(Domestic, irrigation, municipal, manufacturing, industrial, etc.)

6. Description of Well: Depth 75 feet. Type _____
(Dug or drilled)

diameter 8 5/8 inches. Elevation of ground at well site _____ feet, mean sea level.
(As near as known)

Depth to water table 0 feet.

7. Capacity of Well: 5000 g.p.m. with 75 feet drawdown.

_____ g.p.m. with _____ feet drawdown.


Date of test Not tested

If Flowing Well: Measured discharge _____ g.p.m. on _____
(Date)

Shut-in pressure at ground surface _____ lbs. per sq. in. on _____
(Date)

Water is controlled by _____
(Cap, valve, etc.)

Township 335 Range 6 W, W.M.
North

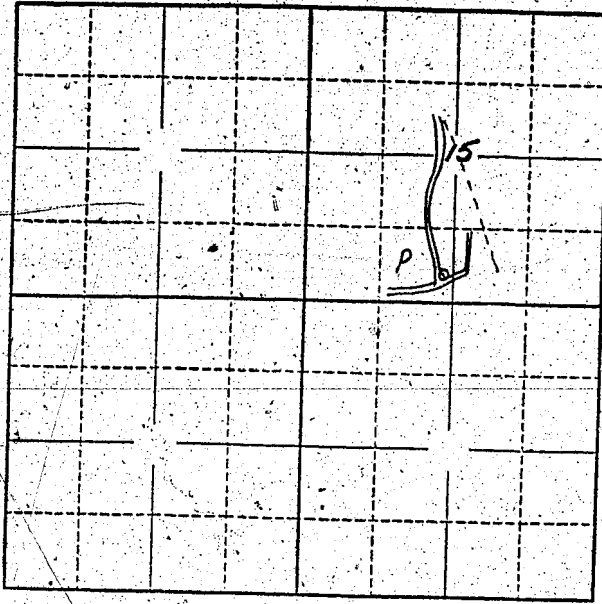

Locate well and acreage of irrigated land on plat.
Scale: 2" = 1 Mile

STATE OF OREGON

County of Josephine

ss.

I, Lyle E. Hayden, President of Trufix Lumber Co

being first duly sworn, do hereby certify that I have read the foregoing Registration Statement and that all of the items therein contained are true to the best of my knowledge and belief.

Lyle E. Hayden
(Signature of Registrant)

Subscribed and sworn to before me this 1 day of August, 1958

My commission expires 2-13-62

Samuel M. Rowe
(Notary Public)

(SEAL)

CERTIFICATE OF REGISTRATION

STATE OF OREGON

County of Marion

ss.

This is to certify that the foregoing Registration Statement was received in the office of the State Engineer on the 4 day of August, 1958, at 8:00 o'clock A.M. and has been duly recorded in said office in Book No. 15 of Registration Statements on page 3702

Witness my hand this 20th day of October, 1959

Laura A. Stanley
(State Engineer)

By _____
(Deputy)

\$20.00