GR-412

REGISTRATION NO. ~~GR-387~~

Registration Statement CERTIFICATE NO. 395

OF CLAIMANT OF RIGHT TO APPROPRIATE GROUND WATER

(Under Chapter 708, Oregon Laws 1955.)

TO THE STATE ENGINEER OF OREGON:

I, O. D. Stephenson

of Jefferson County of Marion

State of Oregon, do hereby make application for a certificate of registration as evidence of a right to appropriate ground water.

1. **Source** from which water is withdrawn is Pump well (Flowing well, pump well, infiltration trench, or tunnel)

2. **Location** is: 1½ mi. S.E. of Jefferson (Approximate distance and direction from nearest city or town)

and is more particularly described as follows:

(a) 490' W. & 40' N. from S.E. corner in well in Div. 64 (Give distance and bearing to corner of section or other legal subdivision)

being within NW¼ of the NW¼ (Smallest legal subdivision) of Sec. 18, Twp. 10 (N. or S.), Rge. 2 W (E. or W.)

or (b) within limits of recorded platted property, town or city:

in Lot ; Block of (Name of plat or addition)

(If within city or town, give name) County of

3. **Construction Work** was begun on spring (Date) 1940; was completed on 1940 (Date)

and the ground water claimed was first used for the purposes set out below on summer (Date) 1940,

since which time the water has been used Continuously (Continuously or intermittently) during season

from 1940 (Date) to 1957 (Date)

4. **Quantity** of water claimed and used is 300 gallons per minute; acre feet per year.

5. **Purpose or Purposes** for which water is used irrigation

(Domestic, irrigation, municipal, manufacturing, industrial, etc.)

6. **Description of Well:** Depth 20 feet. Type drilled (Dug or drilled)

diameter 8" inches. Elevation of ground at well site 245' (As near as known) feet, mean sea level.

Depth to water table feet.

7. **Capacity of Well:** NOT Known g.p.m. with feet drawdown.

g.p.m. with feet drawdown.

Date of test

If Flowing Well: Measured discharge g.p.m. on (Date)

Shut-in pressure at ground surface lbs. per sq. in. on (Date)

Water is controlled by (Cap, valve, etc.)

8. **Casing:** (Give diameter, commercial specifications and depth below ground surface of each casing size.)

8" inch diameter steel casing from 0 to 20 feet

..... inch diameter ..... from ..... to ..... feet

..... inch diameter ..... from ..... to ..... feet

..... inch diameter ..... from ..... to ..... feet

Describe and show depth of shoe, plug, adapter, liner or other details: .....

9. **Perforated Casings or Screens:**

unknown from ..... to .....
(Number per foot and size of perforations, or describe screen)

..... from ..... to .....

..... from ..... to .....

..... from ..... to .....

10. **Log of Well:** (Describe each stratum or formation clearly, indicate if water bearing, and give thickness and depth as indicated.)

MATERIAL	Thickness (Feet)	Depth to Bottom (Feet)
unknown		

GR - 395 A

If log of well is not available, give name and address of driller. Marion West
Salem Oregon

11. **Infiltration Trench:** Covered or open .....

Dimensions: Length ..... ft. Minimum depth ..... ft. Maximum depth ..... ft.

Bottom width ..... ft. Discharge ..... g.p.m. Date of test .....

12. **Tunnel:** Type of lining .....

Dimensions: .....
(Length, course, and cross sectional size)

Position of water bearing stratum with reference to portal of tunnel .....

Log of tunnel: (Preceding table for log of well may be used, if desired. Give footage from portal and character of materials, as pertinent.)

13. **Pumping Equipment:**

(a) Pump Centrifugal (Make, type and size) Capacity 300 g.p.m.

(b) Motor 10 hP electric (Type and horsepower)

14. Location of area irrigated or to be irrigated, or place of use if for purposes other than irrigation.

Township North or South	Range E. or W. of Willamette Meridian	Section	Forty-acre Tract	Number Acres To Be Irrigated	Date of Reclamation
10 S	2 W	7	SW1/4 SW1/4	10.5	1940
"	"	"	SE1/4 SW1/4	1.8	"
"	"	18	NE1/4 NW1/4	0.3	"
"	"	"	NW1/4 NW1/4	1.7	"
				14.3	

15. If the ground water supply is supplemental to an existing water supply, identification of any application for a permit, permit, certificate or adjudicated right to appropriate water made or held by the registrant.

.....

Township 10S Range 2 & 3W W.M.

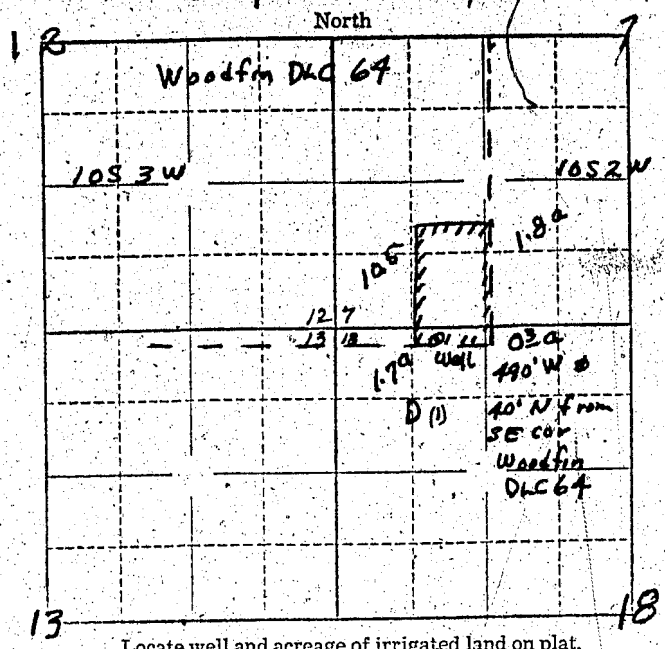

Locate well and acreage of irrigated land on plat.

Scale: ¼" = 1 Mile

STATE OF OREGON
County of O.D. Stephenson } ss.

I, Marion, being first duly sworn, do hereby certify that I have read the foregoing Registration Statement and that all of the items therein contained are true to the best of my knowledge and belief.

O.D. Stephenson
(Signature of Registrant)

Subscribed and sworn to before me this 25 day of March, 1957

My commission expires September 8, 1960 Roy E. Rogers
(Notary Public)

(SEAL)

CERTIFICATE OF REGISTRATION

STATE OF OREGON
County of Marion } ss.

This is to certify that the foregoing Registration Statement was received in the office of the State Engineer on the 25th day of March, 19 57, at 8:00 o'clock A. M. and has been duly recorded in said office in Book No. 3 of Registration Statements on page GR-395 C

~~Construction shall be completed by x-x-x-x-x-x-x-x-x-x-x-x and the water completely applied to x beneficial use by x-x-x-x-x-x-x-x-x-x-x-x~~

Witness my hand this 23rd day of May 19 57.

Lewis A. Stanley
(State Engineer)

By
(Deputy)

- 395 C