

RECEIVED
AUG 4 1958

Registration No. GR - 4120

Certificate No. GR - 3703

STATE ENGINEER
SALEM, OREGON

Registration Statement

OF CLAIMANT OF RIGHT TO APPROPRIATE GROUND WATER

TO THE STATE ENGINEER OF OREGON:

I, Cecil F. Rodgers

of 2446 No. Ninth St. County of Benton

State of Oregon, do hereby make application for a certificate of registration as evidence of a right to appropriate ground water.

1. Source from which water is withdrawn is Pump Well

(Flowing well, pump well, infiltration trench, or tunnel)

2. Location is approx. 3 miles South & West of Corvallis

(Approximate distance and direction from nearest city or town)

and is more particularly described as follows:

(a) 3300' South and 335' East from the NW 1/4 Sec. 24

(Give distance and bearing to corner of section or other legal subdivision)

being within NW 1/4 SW 1/4 of Sec. 24, Twp. 11S, Rge. 5W

(Smallest legal subdivision)

(N. or S.)

(E. or W.)

or (b) within limits of recorded platted property, town or city:

in Lot _____, Block _____ of _____

(Name of plat or addition)

(If within city or town, give name)

County of _____

3. Construction Work was begun on Sept 1954; was completed on Sept 1954

(Date)

(Date)

and the ground water claimed was first used for the purposes set out below on October 1954

since which time the water has been used intermittently for irrigation continuous for house

(Continuously or intermittently)

from 1954 to 1958

(Date)

(Date)

4. Quantity of water claimed and used is 20 gallons per minute; 4 acre feet per year.

5. Purpose or Purposes for which water is used irrigation, livestock and exempt use

(Domestic, irrigation, municipal, manufacturing, industrial, etc.)

6. Description of Well: Depth 57 feet. Type Drilled

(Dug or drilled)

diameter 6" inches. Elevation of ground at well site 295 feet, mean sea level.

(As near as known)

Depth to water table 18' feet.

7. Capacity of Well: 26 g.p.m. with 10 feet drawdown.

g.p.m. with _____ feet drawdown.

Date of test _____

If Flowing Well: Measured discharge _____ g.p.m. on _____

(Date)

Shut-in pressure at ground surface _____ lbs. per sq. in. on _____


(Date)

Water is controlled by _____

(Cap, valve, etc.)

Township 11.5 Range 5W W.M.

North

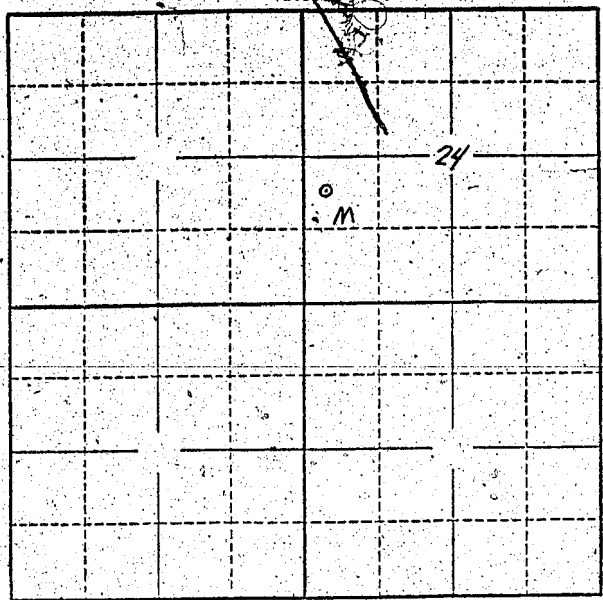

Locate well and acreage of irrigated land on plat.
Scale: 2" = 1 Mile

STATE OF OREGON }
County of Benton } ss.

I, Louis F. Rodgers, being first duly sworn, do hereby certify that I have read the foregoing Registration Statement and that all of the items therein contained are true to the best of my knowledge and belief.

Louis F. Rodgers
(Signature of Registrant)

Subscribed and sworn to before me this 2 day of August, 1958

My commission expires June 7, 1961

C. G. Beaman
(Notary Public)

(SEAL)

CERTIFICATE OF REGISTRATION

STATE OF OREGON }
County of Marion } ss.

This is to certify that the foregoing Registration Statement was received in the office of the State Engineer on the 4th day of August, 1958, at 8:00 o'clock A. M. and has been duly recorded in said office in Book No. 15 of Registration Statements on page 62 **3703**

Witness my hand this 20th day of October, 1959

Lewis A. Stanley
(State Engineer)

By _____
(Deputy)

\$15.00

GR **3703**