

RECEIVED
AUG 4 1958
STATE ENGINEER
SALEM, OREGON

4127
Registration No. GR. [redacted]
Certificate No. GR. 3705

Registration Statement

OF CLAIMANT OF RIGHT TO APPROPRIATE GROUND WATER

TO THE STATE ENGINEER OF OREGON:

I, CLARENCE G. RICE

of Rt. 3 Box 194C Hillsboro County of WASH.

State of Oregon, do hereby make application for a certificate of registration as evidence of a right to appropriate ground water.

1. Source from which water is withdrawn is PUMP Well
(Flowing well, pump well, infiltration trench, or tunnel)
2. Location is: 2 Miles North Hillsboro, Oregon
(Approximate distance and direction from nearest city or town)

and is more particularly described as follows:

(a) 500' NE To SECTION CORNER (N.E. CORNER Sec. 25)
(Give distance and bearing to corner of section or other legal subdivision)

being within NE 1/4 of NE 1/4 of Sec. 25, Twp. T1N, Rge. R3W
(Smallest legal subdivision) (N. or S.) (E. or W.)

or (b) within limits of recorded platted property, town or city:

in Lot _____, Block _____ of _____
(Name of plat or addition)

County of WASHINGTON
(If within city or town, give name)

3. Construction Work was begun on OCTOBER 1947, was completed on OCTOBER 1947
(Date) (Date)

and the ground water claimed was first used for the purposes set out below on JULY 1948
(Date)

since which time the water has been used EVERY SUMMER
(Continuously or intermittently)

from 1948 to 1958
(Date) (Date)

4. Quantity of water claimed and used is 50 gallons per minute; _____ acre feet per year.

5. Purpose or Purposes for which water is used IRRIGATION

(Domestic, irrigation, municipal, manufacturing, industrial, etc.)

6. Description of Well: Depth 60 feet. Type DYIRED
(Dug or drilled)

diameter 8 inches. Elevation of ground at well site _____ feet, mean sea level.
(As near as known)

Depth to water table 15 feet.

7. Capacity of Well: 50 g.p.m. with 36 feet drawdown.

_____ g.p.m. with _____ feet drawdown.


Date of test 1948

If Flowing Well: Measured discharge _____ g.p.m. on _____
(Date)

Shut-in pressure at ground surface _____ lbs. per sq. in. on _____
(Date)

Water is controlled by _____
(Cap, valve, etc.)

Township T1N Range R3W, W.M. North

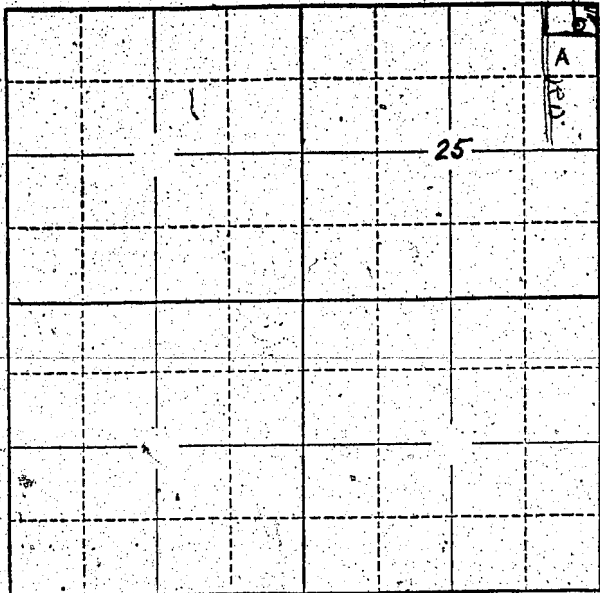

Locate well and acreage of irrigated land on plat.
Scale: 2" = 1 Mile

STATE OF OREGON

County of Washington } ss.

I, Carroll E. Rice, being first duly sworn, do hereby certify that I have read the foregoing Registration Statement and that all of the items therein contained are true to the best of my knowledge and belief.

Carroll E. Rice
(Signature of Registrant)

Subscribed and sworn to before me this 1st day of August, 1958

My commission expires April 30, 1962

Samuel H. Koyan
(Notary Public) for Oregon

(SEAL)

CERTIFICATE OF REGISTRATION

STATE OF OREGON

County of Marion } ss.

This is to certify that the foregoing Registration Statement was received in the office of the State Engineer on the 4th day of August, 1958, at 8:00 o'clock A. M. and has been duly recorded in said office in Book No. 15 of Registration Statements on page OR-3705

Witness my hand this 20th day of October, 1959

Laura A. Stanley
(State Engineer)

15.00

By _____ (Deputy)

GR 3705