

RECEIVED  
AUG 1 1958

STATE ENGINEER  
SALEM, OREGON

Registration No. GR 4128

Certificate No. GR 3706

# Registration Statement

## OF CLAIMANT OF RIGHT TO APPROPRIATE GROUND WATER

TO THE STATE ENGINEER OF OREGON:

I, CLARENCE G. RICE  
of Rt. 3 Box 142C Hillsboro County of Wash.  
(Mailing address)

State of Oregon, do hereby make application for a certificate of registration as evidence of a right to appropriate ground water.

1. Source from which water is withdrawn is Pump Well #2  
(Flowing well, pump well, infiltration trench, or tunnel)
2. Location is: 2 Miles North Hillsboro Oregon  
(Approximate distance and direction from nearest city or town)

and is more particularly described as follows:

(a) 1300 SW 1/4 NE CORNER OF SEC 25  
(Give distance and bearing to corner of section or other legal subdivision)  
being within NE 1/4 of NE 1/4 of Sec. 25 Twp. T1N, Rge. R3W  
(Smallest legal subdivision) (N. or S.) (E. or W.)

or (b) within limits of recorded platted property, town or city:  
in Lot \_\_\_\_\_, Block \_\_\_\_\_ of \_\_\_\_\_  
(Name of plat or addition)

County of WASHINGTON  
(If within city or town, give name)

3. Construction Work was begun on Feb. 1948; was completed on Feb. 1948  
(Date) (Date)

and the ground water claimed was first used for the purposes set out below on July 1948  
(Date)  
since which time the water has been used Every Summer  
(Continuously or intermittently)  
from 1948 to 1958  
(Date) (Date)

4. Quantity of water claimed and used is 30 gallons per minute; \_\_\_\_\_ acre feet per year.

5. Purpose or Purposes for which water is used IRRIGATION  
(Domestic, irrigation, municipal, manufacturing, industrial, etc.)

6: Description of Well: Depth 60 feet. Type Drilled  
(Dug or drilled)  
diameter 8 inches; Elevation of ground at well site \_\_\_\_\_ feet, mean sea level.  
(As near as known)  
Depth to water table 15 feet.

7. Capacity of Well: 50 g.p.m. with 36 feet drawdown.  
\_\_\_\_\_ g.p.m. with \_\_\_\_\_ feet drawdown.

Date of test 1948

If Flowing Well: Measured discharge \_\_\_\_\_ g.p.m. on \_\_\_\_\_  
(Date)


Shut-in pressure at ground surface \_\_\_\_\_ lbs. per sq. in. on \_\_\_\_\_  
(Date)

Water is controlled by \_\_\_\_\_  
(Cap, valve, etc.)





Township T1N Range R3W W.M. North

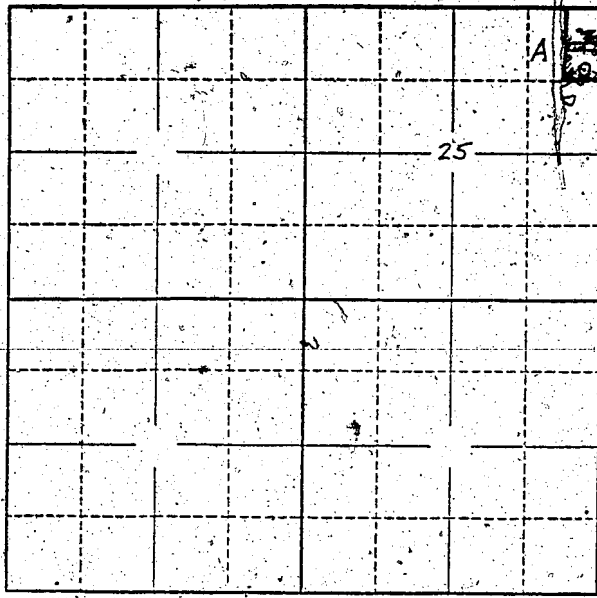

Locate well and acreage of irrigated land on plat.  
Scale: 2" = 1 Mile

STATE OF OREGON  
County of Washington } ss.

I, Charles S. Rice, being first duly sworn, do hereby certify that I have read the foregoing Registration Statement and that all of the items therein contained are true to the best of my knowledge and belief.

Charles S. Rice  
(Signature of Registrant)

Subscribed and sworn to before me this 1st day of August, 1958

My commission expires April 23, 1962

Stanley Proyer  
(Notary Public)

(SEAL)

**CERTIFICATE OF REGISTRATION**

STATE OF OREGON }  
County of Marion } ss.

This is to certify that the foregoing Registration Statement was received in the office of the State Engineer on the 4 day of August, 1958, at 8:00 o'clock A.M. and has been duly recorded in said office in Book No. 15 of Registration Statements on page GR-3706

Witness my hand this 20th day of October, 1959

Lewis A. Stanley  
(State Engineer)

\$1,500

By \_\_\_\_\_  
(Deputy)

GR 3706