

Registration Statement

OF CLAIMANT OF RIGHT TO APPROPRIATE GROUND WATER

TO THE STATE ENGINEER OF OREGON:

I, Fred R. Landt
of St. 2, Box 208-A County of Maryland
(Mailing address)
State of Oregon, do hereby make application for a certificate of registration as evidence
of a right to appropriate ground water.

1. Source from which water is withdrawn is PUMP Well
(Flowing well, pump well, infiltration trench, or tunnel)
2. Location is: 1/2 mile N.W. Silverton
(Approximate distance and direction from nearest city or town)

and is more particularly described as follows:

(a) 260 feet east & 1050 feet south from NW corner Section 19
(Give distance and bearing to corner of section or other legal subdivision)
being within NW 1/4 of SW 1/4 of Sec. 19, Twp. 6 S, Rge. 1 W
(Smallest legal subdivision) (S. or S.) (E. or W.)

or (b) within limits of recorded platted property, town or city:
in Lot _____, Block _____ of _____
(Name of plat or addition)
County of _____
(If within city or town, give name)

3. Construction Work was begun on 1951; was completed on 1951
(Date) (Date)
and the ground water claimed was first used for the purposes set out below on 6-1-51
(Date)
since which time the water has been used Continuously
(Continuously or intermittently)
from 6-1-51 to 8-1-58
(Date) (Date)

4. Quantity of water claimed and used is 80 gallons per minute; _____ acre
feet per year.

5. Purpose or Purposes for which water is used irrigation
(Domestic, irrigation, municipal, manufacturing, industrial, etc.)

6. Description of Well: Depth 156 feet. Type drilled
(Dug or drilled)
diameter 6 inches. Elevation of ground at well site 2000 feet, mean sea level.
(As near as known)
Depth to water table 3.5 feet.

7. Capacity of Well: 120 g.p.m. with 40 feet drawdown.
110 g.p.m. with _____ feet drawdown.

Date of test _____

If Flowing Well: Measured discharge _____ g.p.m. on _____
(Date)

Shut-in pressure at ground surface _____ lbs. per sq. in. on _____
(Date)

Water is controlled by _____
(Cap, valve, etc.)

6" only inch diameter from to feet
 inch diameter from to feet
 inch diameter from to feet
 inch diameter from to feet

Describe and show depth of shoe, plug, adapter, liner or other details: None

No. of screens		from	to
1	(Number per foot and size of perforations, or describe screen)		
		from	to
		from	to
		from	to

[illegible]


.....

- * Position of water bearing stratum with reference to portal of tunnel

(b) Motor Electric
(Type and horsepower)

- GR 4010

North

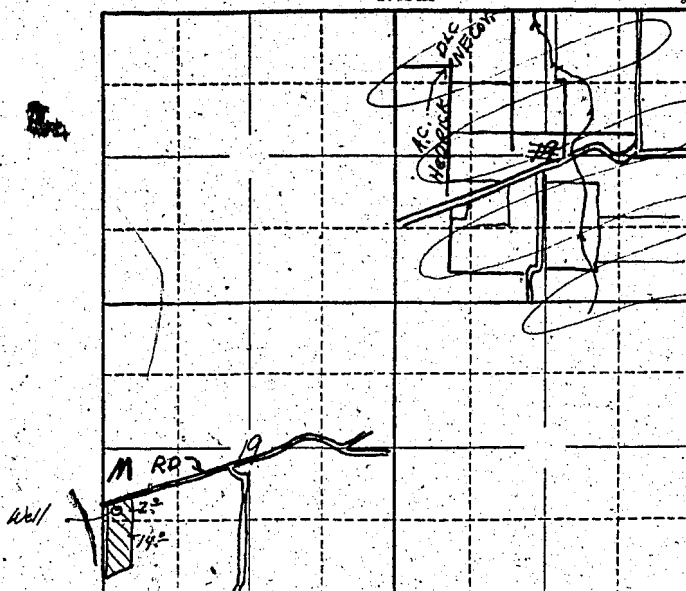

Scale: 2" = 1 Mile

County of Marion

SS

Fred P. Lant
(Signature of Registrant)

(Signature of Registrant)

My commission expires July 7, 1951

(Notary Public)

(SEAL)

STATE OF OREGON

SS.

This is to certify that the foregoing Registration Statement was received in the office of the State Engineer on the 4th day of August, 1956, at 1.00 o'clock A. M. and has been duly recorded in said office in Book No. 16 of Registration Statements on page OR 4010

Witness my hand this 15th day of March, 1960

(State Engineer)

By

(Deputy)

GR 4010